

Yazoo
N 23
6-30-69

MISSISSIPPI
BOARD OF WATER COMMISSIONERS
416 North State Street
Jackson, Mississippi 39201

CODED

WATER WELL DRILLERS LOG

6.30

1969

David BERRY

YAZOO

date well completed

firm name

county well located


LANDOWNER:	description of formations encountered	from	to
(mailing address)			
Thomas Nutt	Clay	0	20
Benton, Miss.	Gravelly SAND	20	40
	CLAY	40	100
WELL LOCATION:	Broken layers of gravel	100	103
sec. 30 T. 11 N. R. 1 E	SAND	103	105
1/2 miles S of Benton	ROCK	105	107
(distance) (direction) (nearest town)	SAND	107	141
WELL PURPOSE:	Clay & SAND	141	185
(home, irrigation, municipal, industrial)	Clay & Shale	185	240
WELL COMPLETION DATA:	CLAY	240	289
(1) diameter (inches) 2"	Sand	289	309
(2) total depth (feet) 309			
(3) static water level (feet) 140 below top of ground.			
(4) casing galv. (material) 299 (depth)			
2" (size) if telescope see back.			
(5) screen 10 (length) 299 (depth to top)			
2" .006 STAINLESS (size) (material)			
(6) pump Air Compressor (HP) (yield gpm)			
elec. (type power)			
(7) electric log No (yes or no)			
(organization running log)			
(8) how well bottom plugged 1/2"			
DRILLERS REMARKS:			

FEB 24 1970

MISS. BD. OF WATER COMMISSIONERS

If well telescopes please sketch and show depths.

GROUND LEVEL

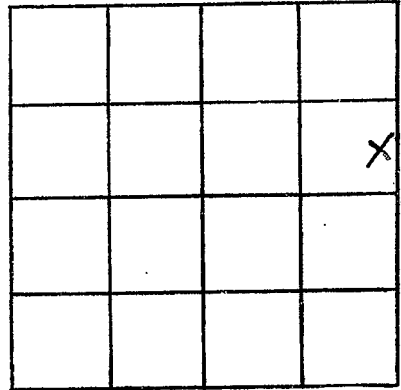

SECTION 30

Please indicate well location X.

ADDITIONAL INFORMATION

If more than one screen, show locations of each on sketch.