

Yazoo  
N 24  
8-11-69

MISSISSIPPI  
BOARD OF WATER COMMISSIONERS  
416 North State Street  
Jackson, Mississippi 39201  
WATER WELL DRILLERS LOG

CODED

8-11-69 19 David Benny Yazoo  
date well completed firm name county well located


LANDOWNER:	description of formations encountered	from	to
<u>Herbert Jones</u>	<u>Clay</u>	<u>0</u>	<u>189</u>
<u>Benton, Miss.</u> (mailing address)	<u>fine sand</u>	<u>189</u>	<u>220</u>
	<u>shale</u>	<u>220</u>	<u>380</u>
WELL LOCATION:	<u>sand-shale</u>	<u>380</u>	<u>411</u>
sec. <u>36</u> T. <u>11</u> N. R. <u>1</u> E	<u>fine sand</u>	<u>411</u>	<u>473</u>
<u>5</u> miles <u>S</u> of <u>Benton</u>	<u>sand good</u>	<u>473</u>	<u>504</u>
(distance) (direction) (nearest town)	<u>sand</u>	<u>504</u>	<u>535</u>
WELL PURPOSE: (home, irrigation, municipal, industrial)			
WELL COMPLETION DATA:			
(1) diameter (inches) <u>2</u>			
(2) total depth (feet) <u>535</u>			
(3) static water level (feet) <u>143</u> below top of ground.			
(4) casing <u>galv.</u> <u>525</u> (material) (depth)			
(size) if telescope see back.			
(5) screen <u>10</u> <u>525</u> (length) (depth to top)			
<u>2"</u> <u>stainless</u> (size) (material)			
(6) pump <u>Air Compressor</u> (HP) (yield gpm)			
<u>Elec.</u> (type power)			
(7) electric log _____ (yes or no)			
_____ (organization running log)			
(8) how well bottom plugged _____			
DRILLERS REMARKS:			

FEB 24 1970

MISS. BD. OF  
WATER COMM.

If well telescopes please sketch and show depths.

GROUND LEVEL

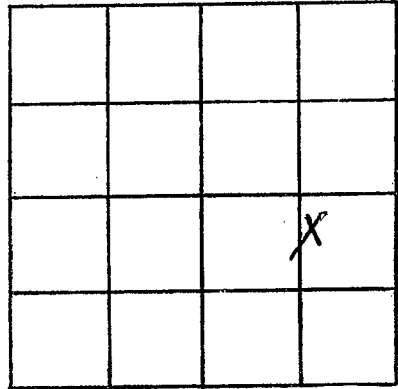

SECTION \_\_\_\_\_

Please indicate well location X.

ADDITIONAL INFORMATION

If more than one screen,  
show locations of each on sketch.