

YA200
N25
5-63

MISSISSIPPI BOARD OF WATER COMMISSIONERS

WATER WELL DRILLERS LOG **CODED**

Date: May, 1963, Driller: David Benny County Yazoo

2320 5428

(Name)

(1) Owner of Land: Hugh Collins
(Name)

R. J. D. Benton, Miss.
(Address)

(2) Location: 1/4, 1/4, Sec. 35 T11 R1 E,
7 miles East, of Benton,
(distance) (direction) (Nearest Town)

(3) Topography: _____
(Hilly) (Flat) (Level)

(4) Purpose of Well: Domestic
(Domestic Irrigation
Municipal, Industrial, Other)

Description & Color of Materials Sand, Clay, Red Clay, Shell, etc.	Thick- ness Feet	Depth Feet
<u>Clay</u>		<u>50</u>
<u>Sandy clay</u>	<u>10</u>	<u>60</u>
<u>Rock</u>	<u>2</u>	<u>62</u>
<u>Sandy clay</u>	<u>188</u>	<u>250</u>
<u>Sandy silt</u>	<u>10</u>	<u>260</u>
<u>Sand</u>	<u>28</u>	<u>288</u>
<u>Clay</u>	<u>6</u>	<u>304</u>

Information upon completion of well:

(1) Diameter 2 inches.

(2) Total Depth 303 feet.

(3) Water Level 71' feet below top of ground.

(4) Cased to _____, Size _____.

(5) Screen: Size 2, Length 20'.


(6) Were any formations sealed against pollution?
_____ yes, _____ no.

If YES depth of formation _____.

Why _____.

Drillers Remarks: _____

CODED

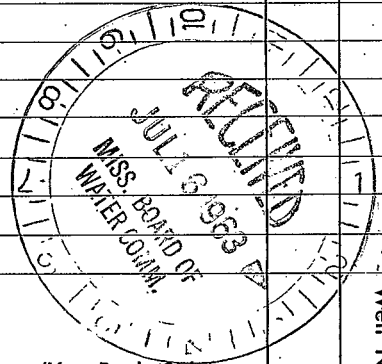

(Use Back Side)

Well No.

1000

1000

