

YAZOO
N-27
7-20-71

CODED

MISSISSIPPI
BOARD OF WATER COMMISSIONERS
416 North State Street
Jackson, Mississippi 39201

CODED

WATER WELL DRILLERS LOG

7-20 1971 L.M. Bud "Cresswell" Yazoo
date well completed firm name county well located

LANDOWNER:
Kyle Seefbeck
Benton, Miss.
(mailing address)

description of formations encountered	from	to
	<u>Clay</u>	<u>0</u>
<u>Sand</u>	<u>260</u>	<u>340</u>

WELL LOCATION:
sec. 32 T 11 N R. 1 E
7 miles SE of Benton
(distance) (direction) (nearest town)

WELL PURPOSE: Domestic
(home, irrigation, municipal, industrial)

CODED

WELL COMPLETION DATA:

(1) diameter (inches) 2

(2) total depth (feet) 340

(3) static water level (feet) 96 below top of ground.

(4) casing Steel 320
(material) (depth)
2"
(size) if telescope see back.

(5) screen 20 320
(length) (depth to top)
2" Stainless
(size) (material)

(6) pump 0 20
(HP) (yield gpm)
0
(type power)

(7) electric log No
(yes or no)
0
(organization running log)

(8) how well bottom plugged Steel plug


DRILLERS REMARKS:

AUG 18 1971

MISS. BD. OF
WATER COMMISSIONERS

If well telescopes please sketch and show depths.

GROUND LEVEL

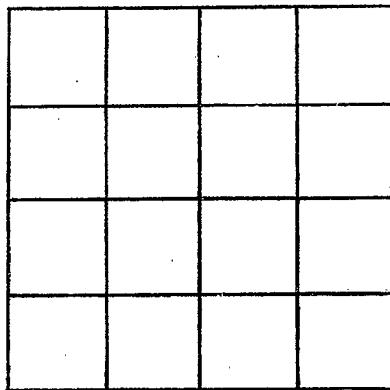

SECTION _____

Please indicate well location X.

ADDITIONAL INFORMATION

If more than one screen,
show locations of each on sketch.