

ELOG # 240

YAZOO  
N 28  
3-13-72

MISSISSIPPI  
BOARD OF WATER COMMISSIONERS  
416 North State Street  
Jackson, Mississippi 39201  
WATER WELL DRILLERS LOG

**CODED**

March 13 19 72 JEECOAT DRILLING CO. YAZOO  
date well completed firm name county well located

LANDOWNER:	Description of formations encountered	from	to
YAZOO COUNTY SCHOOL	Clay	0	80
LINWOOD MISS.	Sand Brks	80	125
(mailing address)	Clay	125	131
WELL LOCATION:	Clay with sand stks	131	218
sec. 13 T 11 N R 1 E S W	sand	218	333
7 miles S E of Benton	shell	333	360
(distance) (direction) (nearest town)	sand with shell stks	360	386
WELL PURPOSE: Municipal	sand	386	444
(home, irrigation, municipal, industrial)	shell	444	470
WELL COMPLETION DATA:	sand with shell stks	470	562
(1) diameter (inches) 4 x 2 1/2	find sand	562	581
(2) total depth (feet) 973	shell Brks	581	588
(3) static water level (feet) 154 below top of ground.	sand	588	603
(4) casing 4" (material) 400ft. (depth)	shell	603	642
2 1/2 (size) if telescope see back.	sand with shell stks	642	668
(5) screen 40ft. (length) 925 (depth to top)	sand	668	722
2 1/2 (size) stainless steel (material)	sand with Brks	722	870
(6) pump 5 (HP) 50 (yield gpm)	shell	870	924
A C (type power)	sand	924	980
(7) electric log Yes (yes or no)	sand with shell stks	980	1028
Miss GEOLOGICAL SURVEY (organization running log)			
(8) how well bottom plugged steel rod			
2" x 1" Swedge			
DRILLERS REMARKS: Sand was Very find.			


**CODED**

MAY 28 1972


MISS. BOARD OF WATER COMMISSIONERS

If well telescopes please sketch and show depths.

GROUND LEVEL

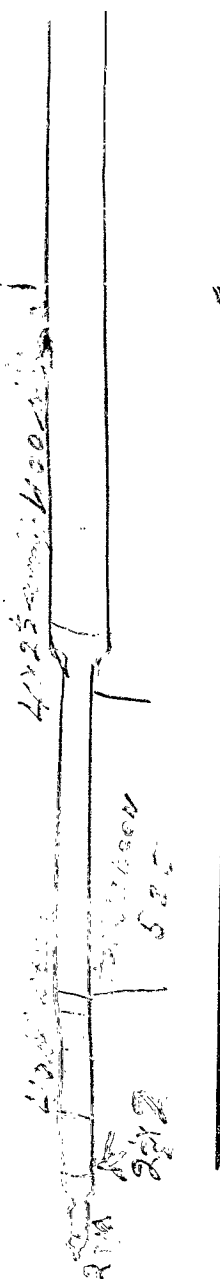

If more than one screen, show locations of each on sketch.

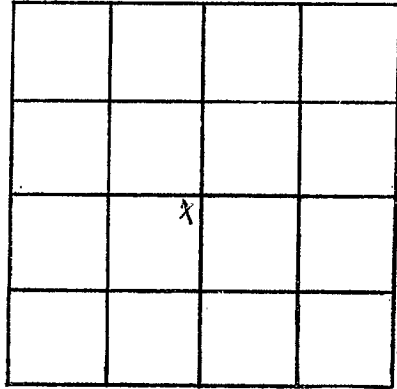

SECTION 13

Please indicate well location X.

ADDITIONAL INFORMATION

A series of horizontal lines for additional information.