

YAZOO
N 29
7-22-74

MISSISSIPPI
BOARD OF WATER COMMISSIONERS
416 North State Street
Jackson, Mississippi 39201

CODED

WATER WELL DRILLERS LOG

July 22 1974 E.M. "Bud" Cresswell Yazoo
date well completed firm name county well located

LANDOWNER:
Shell Pipe Line Co.
Houston Texas
(mailing address)

description of formations encountered	from	to
Clay	0	50
Clay	50	75
Clay	75	320
Sandy Shale	320	440
Sand	440	560

WELL LOCATION:
sec. 18 T 11 N R 1 E
2 miles East of Benton
(distance) (direction) (nearest town)

WELL PURPOSE: Industrial
(home, irrigation, municipal, industrial)

- WELL COMPLETION DATA:
- (1) diameter (inches) 4
 - (2) total depth (feet) 560
 - (3) static water level (feet) 125 below top of ground.
 - (4) casing steel, 520 (material), (depth)
4 (size) if telescope see back.
 - (5) screen 40, 520 (length), (depth to top)
2, stainless (size) (material)
 - (6) pump 3, 35 (HP), (yield gpm)
0 (type power)
 - (7) electric log No (yes or no)
0 (organization running log)
 - (8) how well bottom plugged
Steel plug

CODED


RECEIVED
AUG 15 1974

MISS. BD. OF WATER COMMISSIONERS

DRILLERS REMARKS:

If well telescopes please sketch and show depths.

GROUND LEVEL

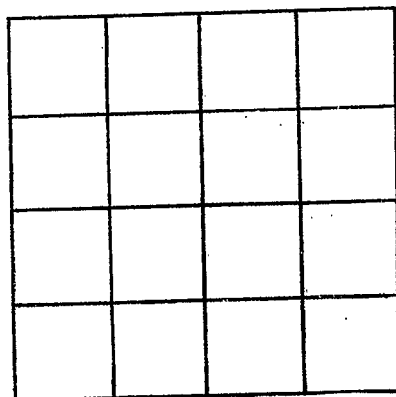

SECTION _____

Please indicate well location X.

ADDITIONAL INFORMATION

If more than one screen,
show locations of each on sketch.