

YAZOO  
N 30  
12-14-74

MISSISSIPPI  
BOARD OF WATER COMMISSIONERS  
416 North State Street  
Jackson, Mississippi 39201

CODED

WATER WELL DRILLERS LOG

Dec-14-1974 date well completed  
John A Davis firm name  
044 Yazoo county well located

LANDOWNER: Mrs. Edna Campbell  
Benton Miss.  
(mailing address)


description of formations encountered	from	to
light clay	0	40
Blue	40	90
Mud	70	90
Blue	90	200
<del>Sand</del> Sand	200	220
Blue	220	240
3 streaks	240	300
Blue	300	340
Sand Good	340	350
Blue	350	380
Sand Good	380	440

WELL LOCATION:  
sec. 33 T 11 N R 1 E  
8 miles East of Benton  
(distance) (direction) (nearest town)

WELL PURPOSE:  
(home, irrigation, municipal, industrial)

- WELL COMPLETION DATA:
- (1) diameter (inches) 2"
  - (2) total depth (feet) 440'
  - (3) static water level (feet) 70' below top of ground
  - (4) casing PVC (material) (depth) (size) If telescope see back.
  - (5) screen 10' (length) 430' (depth to top) (size) PVC (material)
  - (6) pump 3 (HP) 25 (yield gpm) Elect. (type power)
  - (7) electric log no (yes or no) (organization running log)
  - (8) how well bottom plugged Fin

DRILLERS REMARKS:  
Good Drilling

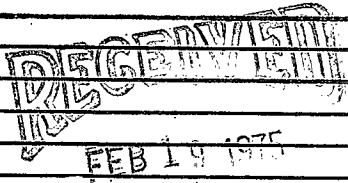

MISS. BD. OF WATER COMMISSIONERS

If well telescopes please sketch and show depths.

GROUND LEVEL


SECTION \_\_\_\_\_

Please indicate well location X.

ADDITIONAL INFORMATION

If more than one screen, show locations of each on sketch.