

YA200

N 2000

8-25-60

WATER WELL DRILLERS LOG

Water Well N-300

Date: Aug. 25, 1960, Driller: John H. Barnes, County: Yazoo

- (1) Owner of Land: Harold Manning
(Name)
Benton, Mississippi
(Address)
- (2) Location: S.E. 1/4, N.W. 1/4, Sec 27 T10 R1 E
7 miles E of Benton
(distance) (direction) (Nearest Town)
- (3) Topography: Hilly
(Hilly) (Flat) (Level)
- (4) Purpose of Well: Farm Use
(Domestic Irrigation
Municipal, Industrial, Other)

Description & Color of Materials Sand, Clay, Red Clay, Shell, etc.	Thick- ness Feet	Depth Feet
<u>yellow clay</u>	<u>45</u>	
<u>Blue Shell</u>	<u>55</u>	
<u>Rock</u>	<u>Not</u>	
<u>water sand</u>	<u>30 ft.</u>	
<u>Shell</u>	<u>175</u>	
<u>Water Sand</u>	<u>110</u>	
		<u>410</u>


Information upon completion of well:

- (1) Diameter 4 inches.
- (2) Total Depth 410 feet.
- (3) Water Level 75 feet below top of ground.
- (4) Cased to 380, Size 2 inch.
- (5) Screen: Size 0006, Length 20 ft.
- (6) Were any formations sealed against pollution?
_____ yes, no.

If YES depth of formation _____

Why _____

Drillers Remarks: _____

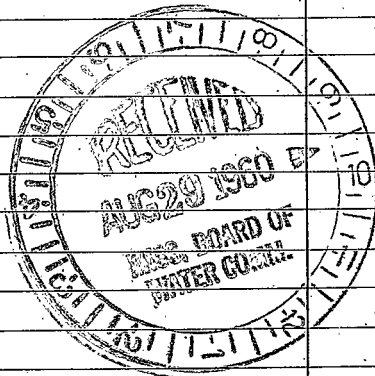

(Use Back Side)

Well No.

