

7/AZOO
 14 2003
 5-11-77

MISSISSIPPI
 BOARD OF WATER COMMISSIONERS
 416 North State Street
 Jackson, Mississippi 39201

WATER WELL DRILLERS LOG

5-11 1977 Jeffcoat Drilling Co. Yazoo
 date well completed firm name county well located

LANDOWNER: Owen Huston

description of formations encountered

from to

Yazoo City miss
RT 2
 (mailing address)

<u>clay and top soil</u>	<u>0</u>	<u>9.5</u>
<u>fine M.B. sand</u>	<u>0</u>	<u>101</u>
<u>shale</u>	<u>107</u>	<u>300</u>
<u>sand</u>	<u>300</u>	<u>326</u>
		<u>7.0</u>

WELL LOCATION:

sec. 7 T. 14 N R. 2 E W. 1
7 miles NE of Yazoo City
 (distance) (direction) (nearest town)

WELL PURPOSE: home
 (home, irrigation, municipal, industrial)

WELL COMPLETION DATA:

- (1) diameter (inches) 2"
- (2) total depth (feet) 326
- (3) static water level (feet) 90 ~~above~~ below top of ground.
- (4) casing PVC, 312,
 (material) (depth)
2"
 (size) if telescope see back.
- (5) screen 12 ft, 312
 (length) (depth to top)
2", PVC
 (size) (material)
- (6) pump air, 20
 (HP) (yield gpm)
AC
 (type power)
- (7) electric log no
 (yes or no)

(organization running log)

(8) how well bottom plugged backwash
value

DRILLERS REMARKS:


RECEIVED
 MAY 19 1977

MISS. BD. OF WATER COMM

if 2 mi NE

Well telescopes please
Sketch and show depths.

GROUND LEVEL

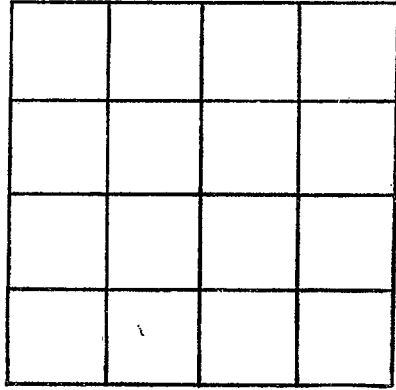

SECTION _____

Please indicate well location X.

ADDITIONAL INFORMATION

A series of horizontal lines for recording additional information, starting below the 'ADDITIONAL INFORMATION' header and extending to the bottom of the page.

If more than one screen,
show locations of each on sketch.