

MISSISSIPPI DEPARTMENT OF NATURAL RESOURCES

Bureau of Land and Water Resources

Southport Mall

P.O. Box 10631

Jackson, Mississippi 39209

WATER WELL DRILLERS LOG

N 2004
 Jan 20
 8-20-85

Aug 20 1985 85 E.M. Bud CRESSWELL YA 200
 date well completed firm name county well located


LANDOWNER:	description of formations encountered	from	to
<u>William Davis</u>			
<u>JACKSON MS.</u> (mailing address)	<u>Shale</u>	<u>40</u>	<u>270</u>
WELL LOCATION: sec. <u>35</u> T <u>11</u> N R <u>1</u> E <u>6</u> miles <u>EAST</u> of <u>BENTON</u> (distance) (direction) (nearest town)	<u>Sand</u>	<u>270</u>	<u>360</u>
WELL PURPOSE: <u>home</u> (home, irrigation, municipal, industrial)			
WELL COMPLETION DATA: (1) diameter (inches) <u>2</u> (2) total depth (feet) <u>360</u> (3) static water level (feet) <u>65</u> below top of ground. (4) casing <u>PVC</u> , <u>340</u> , (material) (depth) <u>2</u> if telescope see back. (size) (5) screen <u>20</u> , <u>340</u> (length) (depth to top) <u>2</u> , <u>PVC</u> (size) (material) (6) pump <u>1</u> , <u>5</u> (HP) (yield gpm) (type power) (7) electric log <u>no</u> (yes or no) (organization running log) (8) how well bottom plugged <u>back wash valve</u>			
DRILLERS REMARKS:			

RECEIVED
 SEP 17 1985

Department of Natural Resources
 Bureau of Land & Water Resources

If well telescopes please sketch and show depths.

GROUND LEVEL

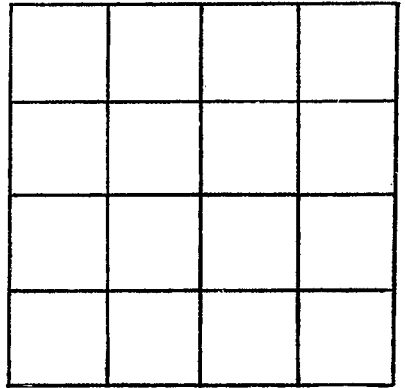

SECTION _____

Please indicate well location X.

ADDITIONAL INFORMATION

If more than one screen,
show locations of each on sketch.