

MISSISSIPPI DEPARTMENT OF NATURAL RESOURCES
Bureau of Land and Water Resources
 Southport Mall
 P.O. Box 10631
 Jackson, Mississippi 39209
WATER WELL DRILLERS LOG

YAZOO
N2005

June 10 1986 E.M. Bud Gesswell YAZOO
 date well completed firm name county well located


LANDOWNER:
Hilton Beow
Vaughan, Ms.
 (mailing address)

description of formations encountered	from	to
<u>Surface</u>	<u>0</u>	<u>30</u>
<u>blue clay</u>	<u>30</u>	<u>160</u>
<u>Sandy shale</u>	<u>160</u>	<u>380</u>
<u>Sand</u>	<u>380</u>	<u>460</u>

WELL LOCATION:
 sec. 5 T. 11 N. R. 1 E
5 miles EAST of Bevton
 (distance) (direction) (nearest town)

WELL PURPOSE: Home
 (home, irrigation, municipal, industrial)

- WELL COMPLETION DATA:**
- (1) diameter (inches) 2
 - (2) total depth (feet) 460
 - (3) static water level (feet) 110 below top of ground.
 - (4) casing PVC 440
 (material) (depth)
2 if telescope see back.
 (size)
 - (5) screen 20 440
 (length) (depth to top)
2 PVC
 (size) (material)
 - (6) pump Air Compressor
 (HP) (yield gpm)
 (type power)
 - (7) electric log No
 (yes or no)
 (organization running log)
 - (8) how well bottom plugged:
Drill wash

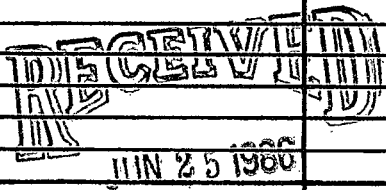


Department of Natural Resources
 Bureau of Land & Water Resources

DRILLERS REMARKS:

If well telescopes please sketch and show depths.

GROUND LEVEL

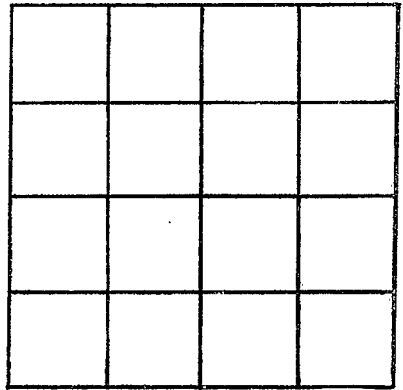

SECTION _____

Please indicate well location X.

ADDITIONAL INFORMATION

If more than one screen, show locations of each on sketch.