

MISSISSIPPI DEPARTMENT OF NATURAL RESOURCES

Bureau of Land and Water Resources

Southport Mall

P.O. Box 10631

Jackson, Mississippi 39209

WATER WELL DRILLERS LOG

YAZOO
L
2013

MAY 1 date well completed      86 K.M. Bud CRESSWELL firm name      YAZOO county well located

LANDOWNER:  
 Jerry Barrier  
 Yazoo City, MS.  
 (mailing address)

description of formations encountered	from	to
	clay	0
sand	60	90

WELL LOCATION:  
 sec. 20 T 11 N R 2 W E  
 5 miles South of Yazoo City  
 (distance) (direction) (nearest town)

WELL PURPOSE: farm  
 (home, irrigation, municipal, industrial)

WELL COMPLETION DATA:

(1) diameter (inches) 4

(2) total depth (feet) 90

(3) static water level (feet) 22 below top of ground.

(4) casing PVC 70  
 (material) (depth)

4 if telescope see back.  
 (size)

(5) screen 20 70  
 (length) (depth to top)

4 PVC  
 (size) (material)

(6) pump 1 20  
 (HP) (yield gpm)


(type power) \_\_\_\_\_

(7) electric log no  
 (yes or no)

(organization running log) \_\_\_\_\_

(8) how well bottom plugged  
Back wash


DRILLERS REMARKS:

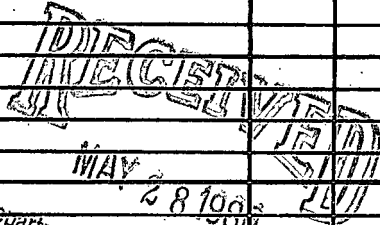

Department of Natural Resources  
 Bureau of Land & Water Resources

If well telescopes please sketch and show depths.

GROUND LEVEL

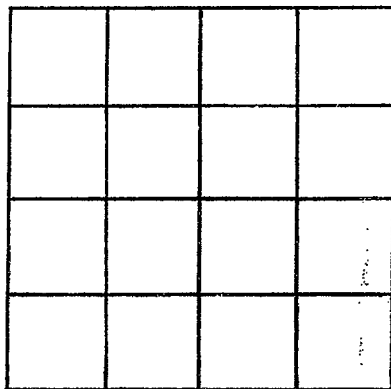

SECTION \_\_\_\_\_

Please indicate well location X.

ADDITIONAL INFORMATION

If more than one screen,  
show locations of each on sketch.