

YA200

MISSISSIPPI BOARD OF WATER COMMISSIONERS

0

11-6-62

WATER WELL DRILLERS LOG

Date: Nov 6, 1962, Driller: M^e. Kay County Yazoo
(Name)

| (1) Owner of Land: <u>Jane Thomas</u> (Name) | Description & Color of Materials Sand, Clay, Red Clay, Shell, etc. | Thick- ness Feet | Depth Feet |
|--|---|------------------------|---------------|
| <u>Vaughn</u> (Address) | <u>Top Sand</u> | <u>0</u> | <u>5</u> |
| (2) Location: <u>1/4</u> , <u>1/4</u> , Sec. <u>T</u> , R <u>R</u> | <u>Red Sandy Clay</u> | <u>5</u> | <u>10</u> |
| <u>5</u> miles <u>SW</u> of <u>Vaughn</u> (distance) (direction) (Nearest town) | <u>Mud Sand</u> | <u>10</u> | <u>20</u> |
| (3) Topography: <input checked="" type="checkbox"/> (Hilly) <input type="checkbox"/> (Flat) <input type="checkbox"/> (Level) | <u>Coarse Sand</u> | <u>21</u> | <u>25</u> |
| (4) Purpose of Well: <u>Home</u> (Domestic Irrigation Municipal, Industrial, Other) | <u>to HP SW Pump</u> | <u>25</u> | <u>35</u> |


Information upon completion of well:

- (1) Diameter 2 inches.
- (2) Total Depth 35 feet.
- (3) Water Level 16 feet below top of ground.
- (4) Cased to _____, Size _____.
- (5) Screen: Size 207, Length 5 ft.
- (6) Were any formations sealed against pollution?
_____ yes, no.

If YES depth of formation _____

Why _____

Drillers Remarks: _____

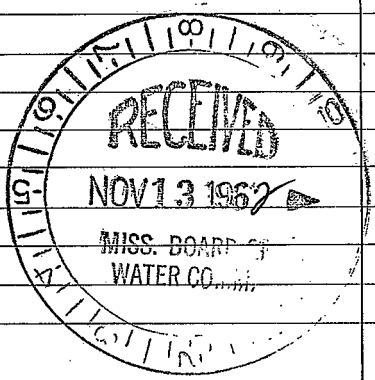

(Use Back Side)

Well No.

