

YA200

MISSISSIPPI BOARD OF WATER COMMISSIONERS

0012

2-22-62

WATER WELL DRILLERS LOG

CODED

Date: Feb 22, 1962 Driller: M<sup>rs</sup> Kay Daulton County Yazoo

5465

(1) Owner of Land: Ward Pepper  
(Name)

Wardson Miss  
(Address)

(2) Location: 8 11 25  
1/4, 1/4, Sec. 9 T. R

8 miles W of Wardson  
(distance) (direction) (Nearest Town)

(3) Topography:  (Hilly)  (Flat)  (Level)

(4) Purpose of Well: Home  
(Domestic Irrigation  
Municipal, Industrial, Other)

Description & Color of Materials Sand, Clay, Red Clay, Shell, etc.	Thick- ness Feet	Depth Feet
<u>White Clay</u>	<u>0</u>	<u>31</u>
<u>Red Sand</u>	<u>21</u>	<u>42</u>
<u>Blue Clay - Sand</u>	<u>42</u>	<u>63</u>
<u>Blue Clay</u>	<u>63</u>	<u>84</u>
<u>" "</u>	<u>84</u>	<u>105</u>
<u>" "</u>	<u>105</u>	<u>124</u>
<u>" "</u>	<u>126</u>	<u>147</u>
<u>" "</u>	<u>147</u>	<u>168</u>
<u>Clay - Sand Slaw</u>	<u>168</u>	<u>189</u>
<u>" "</u>	<u>189</u>	<u>210</u>
<u>Clay</u>	<u>210</u>	<u>234</u>
<u>" "</u>	<u>236</u>	<u>257</u>
<u>Clay - Fine Sand</u>	<u>257</u>	<u>278</u>
<u>med Sand</u>	<u>278</u>	<u>288</u>

Information upon completion of well:

(1) Diameter 2 inches.

(2) Total Depth 288 feet.

(3) Water Level 126 feet below top of ground.


(4) Cased to \_\_\_\_\_, Size \_\_\_\_\_

(5) Screen: Size 006, Length 10ft <sup>SS.</sup>

(6) Were any formations sealed against pollution?  
\_\_\_\_\_ yes,  no.

Set 006x10ft SS.  
126 ft tube  
Rod Pump  
Cylinder Set 147ft

CODED

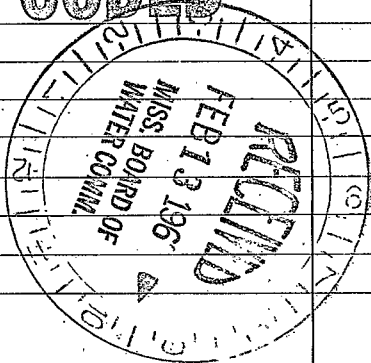

(Use Back Side)

Well No.

