

MISSISSIPPI  
BOARD OF WATER COMMISSIONERS  
416 North State Street  
Jackson, Mississippi 39201

**CODED** **CODED**

WATER WELL DRILLERS LOG

*Yazoo*  
016  
11-13-68

11/13 1968 *Forest Drilling* *Yazoo*  
date well completed firm name county well located

LANDOWNER: *A. B. Vaughan*  
*Vaughan, Miss.*

(mailing address)

WELL LOCATION:

sec. 4 T. 11 N. R. 2 E  
3 miles *N/W* of *Vaughan*  
(distance) (direction) (nearest town)

WELL PURPOSE: *Home*  
(home, irrigation, municipal, industrial)

WELL COMPLETION DATA:

- (1) diameter (inches) 2"
- (2) total depth (feet) 220'
- (3) static water level (feet) 83' below above top of ground.
- (4) casing Galv. 210'  
(material) (depth)  
2" if telescope see back.  
(size)
- (5) screen 10' 210'  
(length) (depth to top)  
2" stainless steel  
(size) (material)
- (6) pump Air (Bryarner)  
(HP) (yield gpm)  
Elect. 15  
(type power)
- (7) electric log No  
(yes or no)  
  
(organization running log)
- (8) how well bottom plugged 2" B/W  
Galv.

description of formations encountered	from	to
<i>Brown clay</i>	0	14
<i>Clay + red sand</i>	14	20
<i>hard streaks clay</i>	20	40
<i>sand</i>	40	60
<i>Clay</i>	60	81
<i>Clay + streaks mucky sand</i>	81	122
<i>fine sand + streaks clay</i>	122	163
<i>fine sand</i>	163	204
<i>fine sand</i>	204	225

**CODED**


JAN - 9 1969

DRILLERS REMARKS:

BASE OF WATER

If well telescopes please sketch and show depths.

GROUND LEVEL

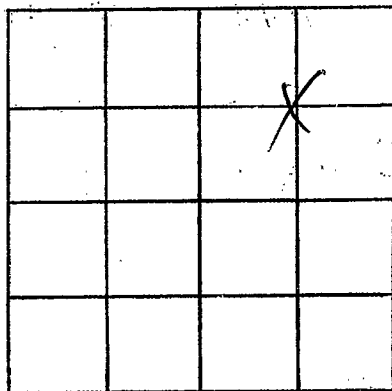

SECTION 4

Please indicate well location X.

ADDITIONAL INFORMATION

If more than one screen, show locations of each on sketch.