

Yazoo
 17
 8-69

MISSISSIPPI
 BOARD OF WATER COMMISSIONERS
 416 North State Street
 Jackson, Mississippi 39201

CODED

WATER WELL DRILLERS LOG


August 19 69 John Davis Yazoo
 date well completed firm name county well located

LANDOWNER:	description of formations encountered	from	to
A S Nichols 2 Pine wood Lane (mailing address)			
WELL LOCATION: sec. 8 T. 11 N R. 2 E 1 1/4 miles NW of Deasonville (distance) (direction) (nearest town)	red sand	30	48
WELL PURPOSE: (home, irrigation, municipal, industrial)	Lt. Blue mud	48	70
WELL COMPLETION DATA: (1) diameter (inches) 2" (2) total depth (feet) 90' (3) static water level (feet) 47' below top of ground. (4) casing Galv 85' (material) (depth) 2" if telescope see back. (size) (5) screen 5' 85' (length) (depth to top) 007 2" 5.5' (size) (material) (6) pump K3 4 (HP) (yield gpm) Customer Installed (type power) (7) electric log no (yes or no) (organization running log) (8) how well bottom plugged For	Fine sand	70	74
	Lt. Blue mud	74	83
	Good sand	83	90
DRILLERS REMARKS:			

SEP 3 1969
 MISS. BD. OF
 WATER

If well telescopes please sketch and show depths.

GROUND LEVEL

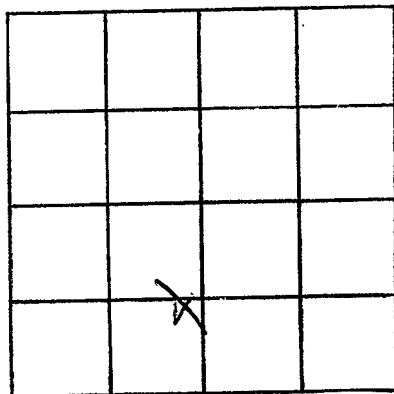

SECTION 8

Please indicate well location X.

ADDITIONAL INFORMATION

If more than one screen,
show locations of each on sketch.