

Yazoo Co
 20
 4-16-70

MISSISSIPPI
 BOARD OF WATER COMMISSIONERS
 416 North State Street
 Jackson, Mississippi 39201

WATER WELL DRILLERS LOG

April 16 1970 Bud Cresswell Yazoo
 date well completed firm name county well located

LANDOWNER:

Wilbert CARTER

description of formations encountered

from to

Vaughn, Miss-
 (mailing address)

clay
 sand

0 15
 15 47

WELL LOCATION:

sec. 11 T. 11 N. R. 3 E. 150
 10 miles EAST of Linton
 (distance) (direction) (nearest town)

WELL PURPOSE: Domestic
 (home, irrigation, municipal, industrial)

WELL COMPLETION DATA:

- (1) diameter (inches) 2
- (2) total depth (feet) 47
- (3) static water level (feet) 26 below top of ground.
- (4) casing galv. 42
 (material) (depth)
 2 If telescope see back.
 (size)
- (5) screen 5 42
 (length) (depth to top)
 2" Stainless
 (size) (material)
- (6) pump (HP) (yield gpm)
 (type power)
- (7) electric log (yes or no)
 (organization running log)
- (8) how well bottom plugged


APR 24 1970

MISS. BD. OF
 WATER COMM.

DRILLERS REMARKS:

If well telescopes please
sketch and show depths.

GROUND LEVEL

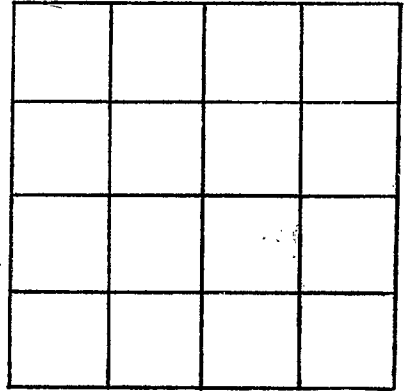

SECTION _____

Please indicate well location X.

ADDITIONAL INFORMATION

If more than one screen,
show locations of each on sketch.