

YA200
 02425
 Log # 248

MISSISSIPPI
 BOARD OF WATER COMMISSIONERS
 416 North State Street
 Jackson, Mississippi 39201

RECORDED

WATER WELL DRILLERS LOG

2/9 1973 Singer Pump Central Div. Yazoo
 date well completed firm name county well located

LANDOWNER: Casey Jones
 Water Association
 Vaughn, Miss.
 (mailing address)

| description of formations encountered | from | to |
|---------------------------------------|------|-----|
| Red Clay | 0 | 5 |
| White Clay | 5 | 47 |
| Sand + Clay | 47 | 81 |
| Hard Shale | 81 | 124 |
| Sand + Shale Strucks | 124 | 315 |
| Shale + Sandy Strucks | 315 | 464 |
| Shale | 464 | 514 |
| Sand + Shale Strucks | 514 | 587 |
| Sand with Shale | 587 | 631 |
| Shale + Sand Strucks | 631 | 710 |
| Sand | 710 | 774 |
| Shale | 774 | 777 |

WELL LOCATION:
 sec. 20 T. 11 N. R. 2 E
 (distance) miles of (direction) (nearest town)

WELL PURPOSE: Domestic
 (home, irrigation, municipal, industrial)

- WELL COMPLETION DATA:
- (1) diameter (inches) 8"
 - (2) total depth (feet) 777'
 - (3) static water level (feet) 92 below top of ground.
 - (4) casing Steel 720' (material) (depth)
 8" if telescope see back.
 (size) + 40' 36"
 - (5) screen 40' 727' (length) (depth to top)
 6" Stainless Steel (size) (material)
 - (6) pump 15 200 (HP) (yield gpm)
 Electric (type power)
 - (7) electric log yes (yes or no)
 Miss. Geo. Survey (organization running log)
 - (8) how well bottom plugged valve


RECORDED

FEB 21 1973

DRILLERS REMARKS:

If well telescopes please sketch and show depths.

GROUND LEVEL

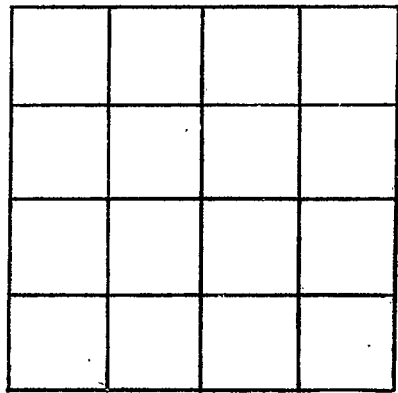

SECTION _____

Please indicate well location X.

ADDITIONAL INFORMATION

If more than one screen, show locations of each on sketch.