

YAZOO
 26
 3-2-73

MISSISSIPPI
 BOARD OF WATER COMMISSIONERS
 416 North State Street
 Jackson, Mississippi 39201

CODED

WATER WELL DRILLERS LOG

March-2 1973 John A. Davis Yazoo
 date well completed firm name county well located

LANDOWNER: Cecil Daniels
 Vaughans Miss.
 (mailing address)

description of formations encountered	from	to
clay light	0	30
white sand	30	50
Blue clay	50	90
mudstone	90	100
Blue clay	100	150
sand strata	150	190
sand good	190	210

WELL LOCATION:
 sec. 37 T. 1 N. R. 2 E. S. 8 W.
 8 miles SE of Benton
 (distance) (direction) (nearest town)

WELL PURPOSE:
 (home, irrigation, municipal, industrial)

- WELL COMPLETION DATA:
- (1) diameter (inches) _____
 - (2) total depth (feet) _____
 - (3) static water level (feet) 2.5' below top of ground.
 - (4) casing PVC / 210
 (material) (depth)
 _____ if telescope see back.
 (size)
 - (5) screen 100' / 210
 (length) (depth to top)
8 slot, 2" PVC
 (size) (material)
 - (6) pump _____ / 2.5
 (HP) (yield gpm)
elect.
 (type power)
 - (7) electric log _____
 (yes or no)

 (organization running log)
 - (8) how well bottom plugged fine


CODED

JUN 20 1973

DRILLERS REMARKS:

If well telescopes please sketch and show depths.

GROUND LEVEL

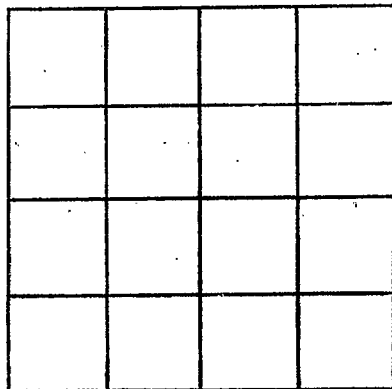

SECTION _____

Please indicate well location X.

ADDITIONAL INFORMATION

If more than one screen,
show locations of each on sketch.