

YAZOO
 Ø 27
 6-20-73

MISSISSIPPI
 BOARD OF WATER COMMISSIONERS
 416 North State Street
 Jackson, Mississippi 39201

CODED

WATER WELL DRILLERS LOG

June 20 1973 John A. Davis. YAZOO
 date well completed firm name county well located

LANDOWNER: Elta ARNOLD
Laughan, Route - 2
 (mailing address)

WELL LOCATION:
 sec. 32 T 11 N R 20 E
8 miles SE of BENTON
 (distance) (direction) (nearest town)

WELL PURPOSE:
 (home, irrigation, municipal, industrial)

WELL COMPLETION DATA:

- (1) diameter (inches) 2"
- (2) total depth (feet) 396"
- (3) static water level (feet) 20' below top of ground.
- (4) casing PVC 396"
 (material) (depth)
- If telescope see back.
 (size)
- (5) screen 20" 410
 (length) (depth to top)
- 8 slot PVC
 (size) (material)
- (6) pump 2 HP 20
 (HP) (yield gpm)
- Elect.
 (type power)
- (7) electric log
 (yes or no)
- (organization running log)
- (8) how well bottom plugged pin.

description of formations encountered	from	to
Red clay	0	20
Grey clay	20	70
Blk 10	70	110
Mud Branch	110	130
Blk	130	150
Rock 2'	150	152
Fine S Stratters	152	200
Rob. Blue	200	230
S Stratters	230	250
Rock Blue	250	275
S fine	275	300
S stratters	300	370
Rock 6'	370	376
Sand grade	376	396

CODED


DRILLERS REMARKS:

JUN 20 1973

MIS

If well telescopes please sketch and show depths.

GROUND LEVEL

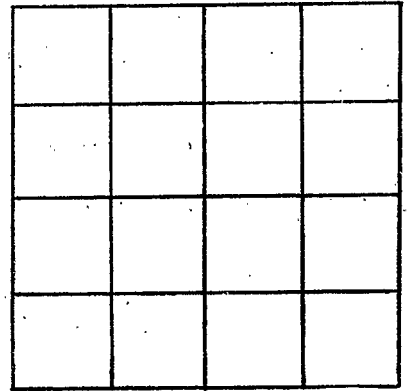

SECTION _____

Please indicate well location X.

ADDITIONAL INFORMATION

If more than one screen,
show locations of each on sketch.