

YA200

WATER WELL DRILLERS LOG

0-300

6-28-60

Date: Jul 28, 1960, Driller: W. E. Hagan, County: Yazoo

(1) Owner of Land: Dixon  
(Name)  
Vaughn  
(Address)

(2) Location: 1/4, 1/4, Sec.     T.     R.      
2 miles W, of Vaughn  
(distance) (direction) (Nearest Town)

(3) Topography:  (Hilly)  (Flat)  (Level)

(4) Purpose of Well: Home  
(Domestic Irrigation  
Municipal, Industrial, Other)

Description & Color of Materials Sand, Clay, Red Clay, Shell, etc.	Thick- ness Feet	Depth Feet
Red Clay	0	21
Red Sandstone	21	42
Red Sand	27	69
White Clay SAND	63	84
" " " "	84	105
" " " "	113	126
BLUE FINE SAND	126	147
MED. BLUE SAND	147	168

2 HP Air Pump

Information upon completion of well:

(1) Diameter 2 inches.

(2) Total Depth 168 feet.

(3) Water Level: 111 feet below top of ground.


(4) Cased to    , Size    .

(5) Screen: Size 1/2", Length 10 ft.

(6) Were any formations sealed against pollution?  
    yes,     no.

If YES depth of formation      
Why    

Drillers Remarks:    

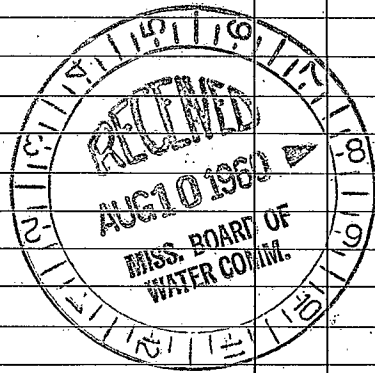

(Use Back Side)

Well No.

