

YA200

MISSISSIPPI BOARD OF WATER COMMISSIONERS

0 2000

4-12-63

WATER WELL DRILLERS LOG

Date: 4/12, 1963, Driller: M^{rs} Kay (Name) County: Yazoo


- (1) Owner of Land: WEE DIXON (Name)
Vaughn Main (Address)
- (2) Location: SW 1/4, NW 1/4, Sec. 30 T11 R2 E
12 miles NW of Canton (distance), (direction), (Nearest Town)
- (3) Topography: (Hilly) (Flat) (Level)
- (4) Purpose of Well: Home (Domestic Irrigation, Municipal, Industrial, Other)

Description & Color of Materials Sand, Clay, Red Clay, Shell, etc.	Thick-ness Feet	Depth Feet
yellow clay	0	21
	21	42
White Clay	42	63
Sandy Brown clay	63	84
	84	105
Brown clay	105	126
	126	147
Fine Sand clay Rock	147	168
Fine Sand clay	168	189
Fine " " "	189	210
Fine Sand and clay	210	231
Fine Sand	231	252
Fine Sand	252	273
Fine to medium Sand	273	285

Information upon completion of well:

- (1) Diameter: 2 inches.
- (2) Total Depth: 285 feet.
- (3) Water Level: 88 feet below top of ground.
- (4) Cased to: _____, Size: _____
- (5) Screen: Size 007, Length 10 ft.
- (6) Were any formations sealed against pollution?
_____ yes, no.

1/2 HP. 120 gal Tank
120 ft jet Pipe

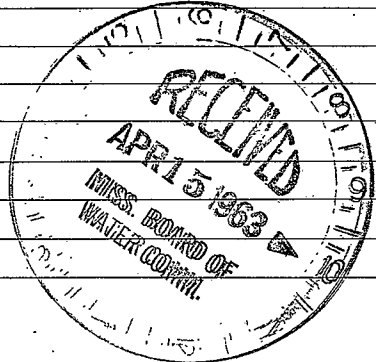

(Use Back Side)

Well No.

