

YA200

MISSISSIPPI BOARD OF WATER COMMISSIONERS

02001

6-8-65

WATER WELL DRILLERS LOG

Date: 6/8/1965, Driller: M. S. Ray, County: Yazoo

(1) Owner of Land: James Moore (Name), Vaughn (Address), (2) Location: NE 1/4, NE 1/4, Sec. 33 T11R2E, 6 miles S of Vaughn, (3) Topography: (Hilly) (Flat) (Level), (4) Purpose of Well: Home (Domestic Irrigation, Municipal, Industrial, Other)

Table with 3 columns: Description & Color of Materials, Thickness Feet, Depth Feet. Rows include Red clay, Sand Clay, Blue Clay, Sandy clay, and Mud Sand.


Information upon completion of well:

(1) Diameter 2 inches, (2) Total Depth 210 feet, (3) Water Level 81 feet below top of ground, (4) Cased to, Size, (5) Screen: Size 007, Length 20, (6) Were any formations sealed against pollution? yes, no.

air compressor

If YES depth of formation, Why

Drillers Remarks:

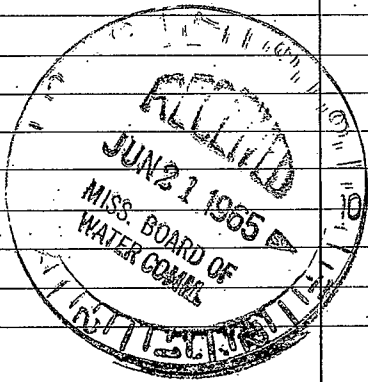

(Use Back Side)

Well No.

[The page contains extremely faint and illegible text, likely bleed-through from the reverse side of the document. No specific words or phrases can be discerned.]