

MISSISSIPPI DEPARTMENT OF NATURAL RESOURCES
Bureau of Land and Water Resources
 Southport Mall
 P.O. Box 10631
 Jackson, Mississippi 39209
WATER WELL DRILLERS LOG

① 2004
 VAZOO
 3-11-85

March 11 1985 E.M. "Bud" Cresswell VAZOO
 date well completed firm name county well located

LANDOWNER:
 M.C. McCullough
 Vaughan, MS.
 (mailing address)

description of formations encountered	from	to
	Surface	0
Dank	30	160

WELL LOCATION:
 sec 24 T 11 N R 2 E
 2 miles South of Vaughan
 (distance) (direction) (nearest town)

WELL PURPOSE: Home
 (home, irrigation, municipal, industrial)

- WELL COMPLETION DATA:**
- (1) diameter (inches) 2
 - (2) total depth (feet) 160
 - (3) static water level (feet) 25 below top of ground.
 - (4) casing PVC, 150
 (material) (depth)
2 if telescope see back.
 (size)
 - (5) screen 10, 150
 (length) (depth to top)
2, PVC
 (size) (material)
 - (6) pump 1, 10
 (HP) (yield gpm)
 (type power)
 - (7) electric log no
 (yes or no)
 (organization running log)

(8) Flow well bottom plugged back wash valve


DRILLERS REMARKS:

RECEIVED
 APR 8 - 1985

Department of Natural Resources
 Bureau of Land & Water Resources

If well telescopes please
sketch and show depths.

GROUND LEVEL

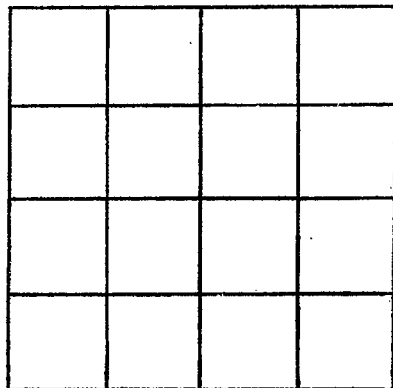

SECTION _____

Please indicate well location X.

ADDITIONAL INFORMATION

If more than one screen,
show locations of each on sketch.