

MISSISSIPPI DEPARTMENT OF NATURAL RESOURCES  
 Bureau of Land and Water Resources  
 Southport Mall  
 P.O. Box 10631  
 Jackson, Mississippi 39209  
**WATER WELL DRILLERS LOG**

Yazoo  
8-5-85

Aug. 5 1985 E.M. "Bud" Cresswell Yazoo  
 date well completed firm name county well located


LANDOWNER:	description of formations encountered	from	to
<u>M.C. McCullough</u>			
<u>Benton Ms. 39039</u> (mailing address)	<u>Surface</u> <u>SAND</u>	<u>0</u> <u>25</u>	<u>25</u> <u>140</u>
<b>WELL LOCATION:</b>			
sec. <u>24</u> T. <u>11</u> N R. <u>2</u> E			
<u>2</u> miles <u>South</u> of <u>Vaughn</u> (distance) (direction) (nearest town)			
<b>WELL PURPOSE:</b> <u>Home</u> (home, irrigation, municipal, industrial)			
<b>WELL COMPLETION DATA:</b>			
(1) diameter (inches) <u>2</u>			
(2) total depth (feet) <u>140</u>			
(3) static water level (feet) <u>25</u> below top of ground.			
(4) casing <u>PVC</u> , <u>130</u> (material) (depth)			
<u>2</u> if telescope see back. (size)			
(5) screen <u>10</u> , <u>130</u> (length) (depth to top)			
<u>2</u> , <u>PVC</u> (size) (material)			
(6) pump <u>1</u> , <u>10</u> (HP) (yield gpm)			
_____ (type power)			
(7) electric log <u>no</u> (yes or no)			
_____ (organization running log)			
(8) <u>had well bottom plugged</u> <u>Back wash valve</u>			
<b>DRILLERS REMARKS:</b>			

**RECEIVED**  
 AUG 11 1985

Department of Natural Resources  
 Bureau of Land & Water Resources

If well telescopes please sketch and show depths.

GROUND LEVEL

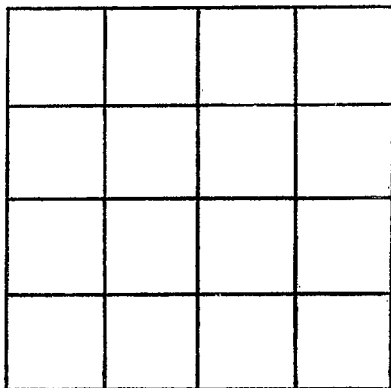

SECTION \_\_\_\_\_

Please indicate well location X.

ADDITIONAL INFORMATION

If more than one screen,  
show locations of each on sketch.