

MISSISSIPPI DEPARTMENT OF NATURAL RESOURCES

Bureau of Land and Water Resources

Southport Mall

P.O. Box 10631

Jackson, Mississippi 39209

WATER WELL DRILLERS LOG

① 2000
 44200
 3-13-85

March 13 1985 E.M. Bud Cresswell 44200
 date well completed firm name county well located


LANDOWNER:	description of formations encountered	from	to
Clarence Moses Vaughan, MS. (mailing address)			
WELL LOCATION: sec. 12 T 11 N R 2 E in Vaughan (distance) miles (direction) of (nearest town)			
WELL PURPOSE: Home (home, irrigation, municipal, industrial)			
WELL COMPLETION DATA:			
(1) diameter (inches) 2			
(2) total depth (feet) 110			
(3) static water level (feet) 40 below top of ground.			
(4) casing PVC, 100, (material) (depth), 2 (size) if telescope see back.			
(5) screen 10, 100 (length) (depth to top), 2 PVC (size) (material)			
(6) pump 1, 10 (HP) (yield gpm), (type power)			
(7) electric log no (yes or no), (organization running log)			
(8) how well bottom plugged bad waste value			
DRILLERS REMARKS:			

RECEIVED
 APR 8 - 1985

Department of Natural Resources
 Bureau of Land & Water Resources

If well telescopes please
sketch and show depths.

GROUND LEVEL

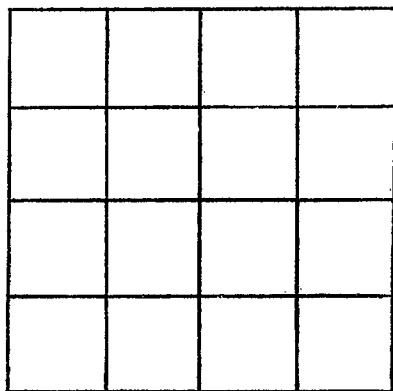

SECTION _____

Please indicate well location X.

ADDITIONAL INFORMATION

If more than one screen,
show locations of each on sketch.