

YAZOO  
P 10  
10-2-72

MISSISSIPPI  
BOARD OF WATER COMMISSIONERS  
416 North State Street  
Jackson, Mississippi 39201

WATER WELL DRILLERS LOG

**CODED**

Oct. 2 1972 E.M. Bud Cresswell Yazoo  
date well completed firm name county well located

LANDOWNER:

J. N. HART

JATARTIA, Miss.  
(mailing address)

description of formations encountered

from to

Clay	0	15
Sand & gravel	15	120
Shale	120	340
Sand	340	460

WELL LOCATION:

sec. 13 T10 N R 4 W  
12 5 of Yazoo  
(distance) (direction) (nearest town)

WELL PURPOSE: FARM  
(home, irrigation, municipal, industrial)

WELL COMPLETION DATA:

- (1) diameter (inches) 4
- (2) total depth (feet) 460
- (3) static water level (feet) 6 below top of ground.
- (4) casing Steel 420 (material), (depth)
- 4 (size) if telescope see back.
- (5) screen 40 420 (length), (depth to top)
- 2 Stainless (size), (material)
- 1 1/2 30 (size), (depth)
- 0 (type power)
- (7) electric log 0 (yes or no)
- 0 (organization running log)
- (8) how well bottom plugged

**CODED**

NOV - 2 1972


DRILLERS REMARKS:

Steel Casing

MISSISSIPPI  
STATE BOARD OF  
WATER COMMISSIONERS

If well telescopes please  
sketch and show depths.

GROUND LEVEL

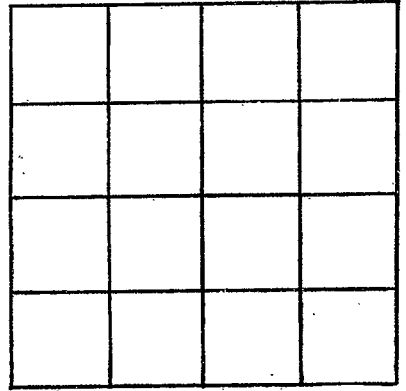

SECTION \_\_\_\_\_

Please indicate well location X.

ADDITIONAL INFORMATION

If more than one screen,  
show locations of each on sketch.