

MISSISSIPPI  
BOARD OF WATER COMMISSIONERS  
416 North State Street  
Jackson, Mississippi 39201

WATER WELL DRILLERS LOG

**CODED**  
72000

YAZOO  
P 11  
10-3-72

Oct 3 1972 E.M. "Bud" Cresswell  
date well completed firm name county well located

LANDOWNER:

G.C. Hoover  
Yazoo City, Miss.  
(mailing address)

description of formations encountered

from to

Clay 0 40  
Sand-gravel 40 89

WELL LOCATION:

sec. 2 T 10 N R 4 E  
8 miles NW of Stanton  
(distance) (direction) (nearest town)

WELL PURPOSE: Domestic  
(home, irrigation, municipal, industrial)

WELL COMPLETION DATA:

- (1) diameter (inches) 2
- (2) total depth (feet) 89
- (3) static water level (feet) 22 below top of ground.
- (4) casing Steel, 84  
(material) (depth)
- 2 if telescope see back.  
(size)
- (5) screen 5, 84  
(length) (depth to top)
- 2, Stainless  
(size) (material)
- (6) pump 3/4, 10  
(HP) (yield gpm)
- (type power)
- (7) electric log 0  
(yes or no)
- 0  
(organization running log)

**CODED**

NOV - 2 1972


(8) how well bottom plugged  
well plug

DRILLERS REMARKS:

MISSISSIPPI  
BOARD OF WATER COMMISSIONERS  
JACKSON, MISSISSIPPI

If well telescopes please  
sketch and show depths.

GROUND LEVEL

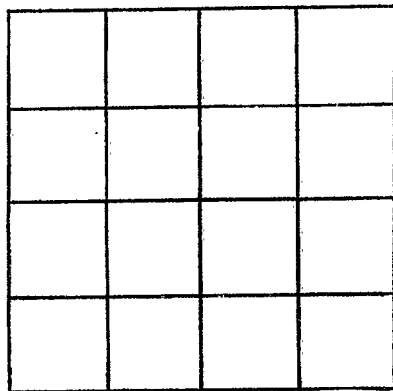

SECTION \_\_\_\_\_

Please indicate well location X.

ADDITIONAL INFORMATION

If more than one screen,  
show locations of each on sketch.