

YAZOO
P 12
10-10-72

MISSISSIPPI
BOARD OF WATER COMMISSIONERS
416 North State Street
Jackson, Mississippi 39201

WATER WELL DRILLERS LOG

CODED

Oct. 10 1972 E.M. "Bud" (Resswell) Yazoo
date well completed firm name county well located

LANDOWNER:
W.L. TRAMMELL, Jr.
SATARTIA, Miss.
(mailing address)

description of formations encountered	from	to
Clay	0	10
Sand - gravel	10	116
blue clay	116	375
chert shell sand	375	810
Sand	810	872
Shale	872	875

WELL LOCATION:
sec. 18 T 10 N R 4 W
7 miles W of Satartia
(distance) (direction) (nearest town)

WELL PURPOSE: Domestic
(home, irrigation, municipal, industrial)

- WELL COMPLETION DATA:
- (1) diameter (inches) 4
 - (2) total depth (feet) 875
 - (3) static water level (feet) 8 below top of ground
 - (4) casing Steel 855
(material) (depth)
 - 4 if telescope see back.
(size)
 - (5) screen 20 855
(length) (depth to top)
 - 2 Stainless
(size) (material)
 - (6) pump 1 20
(HP) (yield gpm)
 - 0
(type power)
 - (7) electric log yes
(yes or no)
 - Steel
(organization running log)

CODED

(8) how well bottom plugged:
Self plugs


DRILLERS REMARKS:

NOV - 2 1972

MIS. ...
WATER ...

If well telescopes please sketch and show depths.

GROUND LEVEL

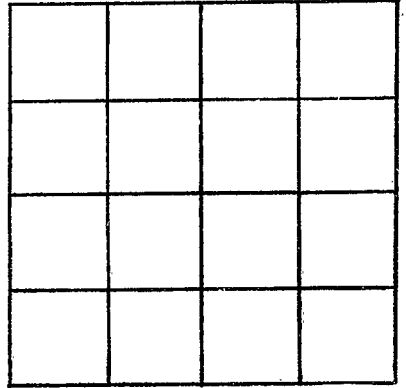

SECTION _____

Please indicate well location X.

ADDITIONAL INFORMATION

If more than one screen,
show locations of each on sketch.