

YAZOO  
P13  
2-13-73

MISSISSIPPI  
BOARD OF WATER COMMISSIONERS  
416 North State Street  
Jackson, Mississippi 39201

**CODED**

WATER WELL DRILLERS LOG

Feb 13 1973 E.M. "Bud" Resowell Yazoo  
date well completed firm name county well located

LANDOWNER:  
*R.T. Frierson*  
*Yazoo City, Miss.*  
(mailing address)

WELL LOCATION:  
sec. 36 T. 10 N. R. 5 E.  
9 miles SW of Atartea  
(distance) (direction) (nearest town)

description of formations encountered	from	to
<i>Clay</i>	<i>0</i>	<i>30</i>
<i>Sand - gravel</i>	<i>30</i>	<i>110</i>
<i>Clay</i>	<i>110</i>	<i>500</i>
<i>Shale</i>	<i>500</i>	<i>545</i>
<i>Sand</i>	<i>545</i>	<i>660</i>

WELL PURPOSE: *Home*  
(home, irrigation, municipal, industrial)

WELL COMPLETION DATA:

(1) diameter (inches) 4 X 2

(2) total depth (feet) 660

(3) static water level (feet) 4 below above top of ground.

(4) casing Steel, 640  
(material) (depth)  
2 if telescope see back.  
(size)

(5) screen 20, 640  
(length) (depth to top)  
2, Stainless  
(size) (material)

(6) pump 3/4, 20  
(HP) (yield gpm)  
0  
(type power)

(7) electric log No  
(yes or no)  
0  
(organization running log)

(8) how well bottom plugged  
Steel plug


DRILLERS REMARKS:

**CODED**

MAR 18 1973

If well telescopes please sketch and show depths.

GROUND LEVEL

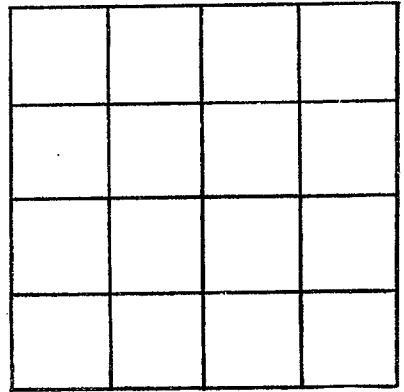

SECTION \_\_\_\_\_

Please indicate well location X.

ADDITIONAL INFORMATION

If more than one screen,  
show locations of each on sketch.