

CODED

MISSISSIPPI
BOARD OF WATER COMMISSIONERS
416 North State Street
Jackson, Mississippi 39201

WATER WELL DRILLERS LOG

YAZOO
P 14
7-12-73

July 12 1973 E.M. "Bud" Cresswell Yazoo
date well completed firm name county well located

LANDOWNER:

E.H. Davis

description of formations encountered

from

to

Yazoo City, Miss.
(mailing address)

Clay
sand - gravel
0 15
15 68

WELL LOCATION:

sec. 18 T 10 N R. 4 E
6 miles W of Sartoris
(distance) (direction) (nearest town)

WELL PURPOSE: Home
(home, irrigation, municipal, industrial)

WELL COMPLETION DATA:

- (1) diameter (inches) 2
- (2) total depth (feet) 68
- (3) static water level (feet) 10 below above top of ground.
- (4) casing steel, 63, (material) (depth)
2 (size) if telescope see back.
- (5) screen 5, 63 (length) (depth to top)
2, 20 inches (size) (material)
- (6) pump 0, 0 (HP) (yield gpm)
0 (type power)
- (7) electric log No (yes or no)
0 (organization running log)

CODED

(8) how well bottom plugged


Steel plug

DRILLERS REMARKS:

AUG 7 1973

If well telescopes please sketch and show depths.

GROUND LEVEL

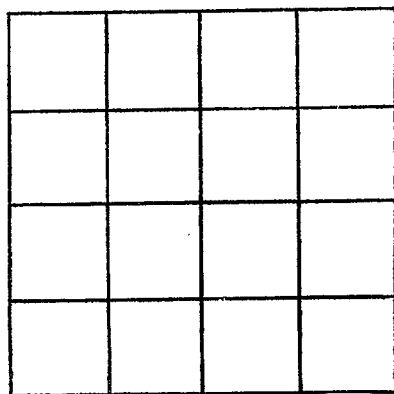

SECTION _____

Please indicate well location X.

ADDITIONAL INFORMATION

If more than one screen,
show locations of each on sketch.