

YA200
P15
11-21-74

MISSISSIPPI
BOARD OF WATER COMMISSIONERS
416 North State Street
Jackson, Mississippi 39201

WATER WELL DRILLERS LOG

CODED

No. 21
date well completed

1974 E.M. "Bud" Cresswell
firm name

YA200
county well located

LANDOWNER:
Walter Martin
SARTARTIA, Miss.
(mailing address)

description of formations encountered	from	to
	clay sand & gravel	0 25

WELL LOCATION:
sec. 18 T. 10 N R. 4 E
5 miles West Sartartia
(distance) (direction) (nearest town)

WELL PURPOSE: home
(home, irrigation, municipal, industrial)

CODED

- WELL COMPLETION DATA:
- (1) diameter (inches) 2
 - (2) total depth (feet) 89
 - (3) static water level (feet) 15 below top of ground.
 - (4) casing steel, 84
(material) (depth)
2 if telescope see back.
(size)
 - (5) screen 5, 84
(length) (depth to top)
2, stainless steel
(size) (material)
 - (6) pump none, 10
(HP) (yield gpm)
0
(type power)
 - (7) electric log No
(yes or no)
0
(organization running log)
 - (8) how well bottom plugged
plug plug


RECEIVED
DEC - 8 1974

DRILLERS REMARKS:

MISS. Bd. OF WATER COMM.

If well telescopes please sketch and show depths.

GROUND LEVEL

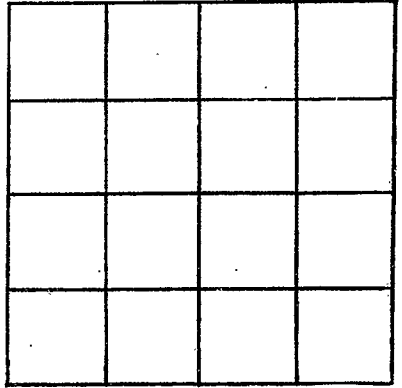

SECTION _____

Please indicate well location X.

ADDITIONAL INFORMATION

If more than one screen,
show locations of each on sketch.