


Yazoo
P 16
8-27-75

MISSISSIPPI
BOARD OF WATER COMMISSIONERS CODED
416 North State Street
Jackson, Mississippi 39201

WATER WELL DRILLERS LOG


Aug. 27 1975 E.M. "Bud" CRESSWELL Yazoo
date well completed firm name county well located

LANDOWNER:	description of formations encountered	from	to
JUANITA HOOPER Yazoo City, Miss. (mailing address)			
WELL LOCATION:			
sec. 2 T 10 N R 4 E 15 S W			
7 miles West of Sartoris			
(distance) (direction) (nearest town)			
WELL PURPOSE: Home			
(home, irrigation, municipal, industrial)			
WELL COMPLETION DATA:			
(1) diameter (inches) 2			
(2) total depth (feet) 89			
(3) static water level (feet) 19 below above top of ground.			
(4) casing Steel 84			
(material) (depth)			
2 If telescope see back.			
(size)			
(5) screen 5 84			
(length) (depth to top)			
2 Stainless			
(size) (material)			
(6) pump 1 10			
(HP) (yield gpm)			
0			
(type power)			
(7) electric log No			
(yes or no)			
0			
(organization running log)			
(8) how well bottom plugged			
Steel plug			
DRILLERS REMARKS:			
AUG 29 1975			

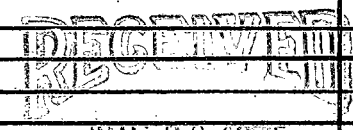

If well telescopes please sketch and show depths.

GROUND LEVEL

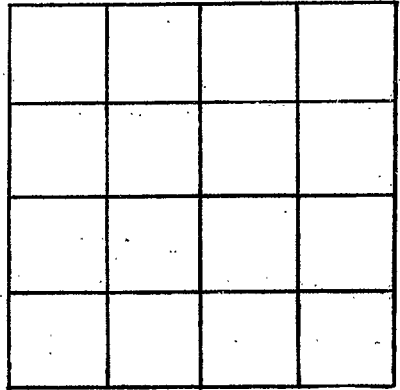

SECTION _____

Please indicate well location X.

ADDITIONAL INFORMATION

If more than one screen, show locations of each on sketch.