

YAZOO
 PIT
 4/4/78
 E Log # 279

MISSISSIPPI
 BOARD OF WATER COMMISSIONERS
 416 North State Street
 Jackson, Mississippi 39201

CODED

WATER WELL DRILLERS LOG

4-4 1978 E.M. "Bud" Caswell Yazoo
 date well completed firm name county well located

LANDOWNER:
 Betty Gray
 SATARTIA, MS.
 (mailing address)

WELL LOCATION:
 sec. 18 T. 10 N R. 5 E
 6 miles West of Satartia
 (distance) (direction) (nearest town)

WELL PURPOSE: Home
 (home, irrigation, municipal, industrial)

- WELL COMPLETION DATA:
- (1) diameter (inches) 4"
 - (2) total depth (feet) 890
 - (3) static water level (feet) 5 below top of ground.
 - (4) casing steel 600 (material) (depth)
 4 (size) if telescope see back.
 - (5) screen 20 600 (length) (depth to top)
 2 stainless (size) (material)
 - (6) pump 1 25 (HP) (yield gpm)
 0 (type power)
 - (7) electric log yes (yes or no)
 No. State G. S. (organization running log)
 - (8) how well bottom plugged
 steel plug

description of formations encountered	from	to
Clay	0	20
Sand-graup	20	145
Clay	145	400
Dark shale	400	510
Sand	510	575
Shale	575	610
Sand	610	640
Dark-stripe shale	640	800
Sand	800	890

CODED


RECEIVED
 MAY 3 - 1978

MISS. BD. OF WATER COMM.

DRILLERS REMARKS:
 Drilled to 890 feet

If well telescopes please
sketch and show depths.

GROUND LEVEL

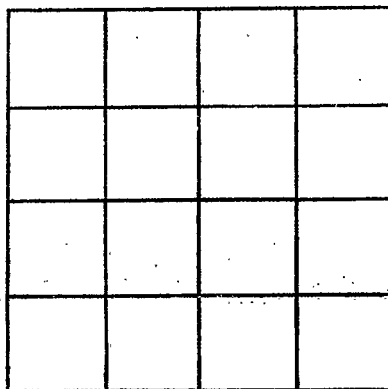

SECTION _____

Please indicate well location X.

ADDITIONAL INFORMATION

If more than one screen,
show locations of each on sketch.