

MISSISSIPPI DEPARTMENT OF NATURAL RESOURCES

Bureau of Land and Water Resources

Southport Mall

P.O. Box 10631

Jackson, Mississippi 39209

WATER WELL DRILLERS LOG

CODED

YAZOO  
P. 23  
3-20-81

March 20 1981 E.M. "Bud" Cresswell Yazoo  
date well completed firm name county well located

LANDOWNER: Bobby Rayland  
SARTARIA, MS.  
(mailing address)

description of formations encountered	from	to
Clay	0	20
Sand-gravel	20	140

WELL LOCATION:  
sec. 7 T. 10 N R. 24 W  
8 miles NW of SARTARIA  
(distance) (direction) (nearest town)

WELL PURPOSE: Home  
(home, irrigation, municipal, industrial)

WELL COMPLETION DATA:

(1) diameter (inches) 2

(2) total depth (feet) 140

(3) static water level (feet) 20 below top of ground.


(4) casing PVC 120 (material) (depth)  
2 (size) If telescope see back.

(5) screen 20 120 (length) (depth to top)  
2 PVC (size) (material)

(6) pump 1 10 (HP) (yield gpm)  
(type power)

(7) electric log No. (yes or no)

(organization running log)

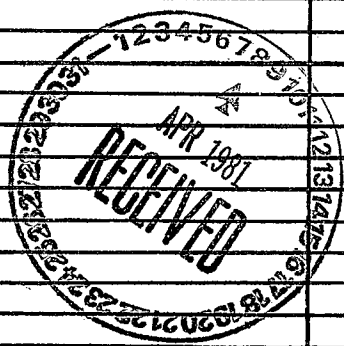


(8) How well bottom plugged back wash

DRILLERS REMARKS:

DEPT. OF NATURAL RESOURCES  
BUREAU OF LAND & WATER RESOURCES  
APR - 8 1981  
RECEIVED

If well telescopes please  
sketch and show depths.

GROUND LEVEL

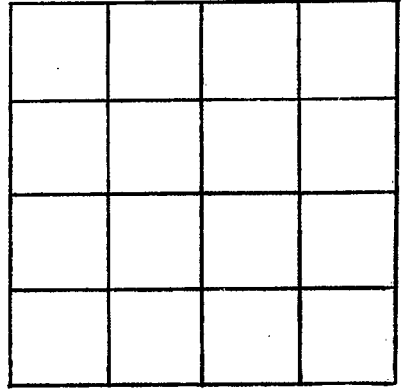

SECTION \_\_\_\_\_

Please indicate well location X.

ADDITIONAL INFORMATION

A series of horizontal lines for entering additional information, starting below the 'ADDITIONAL INFORMATION' header and extending to the bottom of the page.

If more than one screen,  
show locations of each on sketch.