

BOARD OF WATER COMMISSIONERS
416 North State Street
Jackson, Mississippi 39201

3240
CODED

Yazoo
P24
10-13-80

WATER WELL DRILLERS LOG

32-43-18
90-3408

10/13 1980
date well completed

Dyer
firm name

Yazoo
county well located

LANDOWNER:
JOHN PEASTER

description of formations encountered	depth	
	from	to
Clay	0	18
fine sand	18	38
sand & gravel	38	100

Yazoo City, MS
(mailing address)


WELL LOCATION:
sec. R 100 N 4 E
S 11 W
11 miles SW of Yazoo City
(distance) (direction) (nearest town)

WELL PURPOSE: Irrigation
(home, irrigation, municipal, industrial)


WELL COMPLETION DATA:

- (1) diameter (inches) 16
- (2) total depth (feet) 100
- (3) static water level (feet) 19' below top of ground
- (4) casing Steel 100'
(material) (depth)
16" (size) If telescope size back.
- (5) screen 40' 60'
(length) (depth to top)
16" Steel
(size) (material)
- (6) pump 60 3000
(HP) (yield gpm)
Diesel
(type power)
- (7) electric log (yes or no)
(organization running log)
- (8) how well bottom plugged plate

CODED

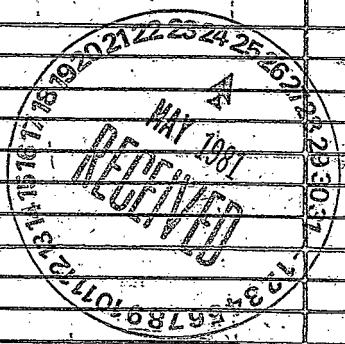

DRILLERS REMARKS:

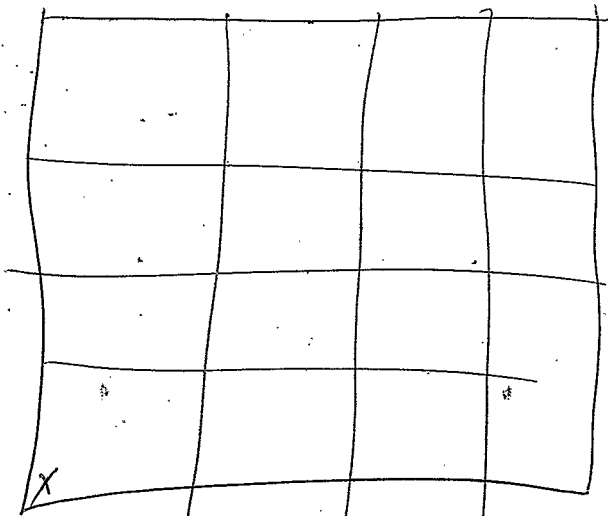

Sec ~~12~~ 12

