

MISSISSIPPI DEPARTMENT OF NATURAL RESOURCES

Bureau of Land and Water Resources

Southport Mall

P.O. Box 10631

Jackson, Mississippi 39209

WATER WELL DRILLERS LOG

CODED

YA200  
P28  
02158

June 18 1987 E.M. Bud CRESSWELL YA200  
date well completed firm name county well located

LANDOWNER:	description of formations encountered	from	to
Clifford Trammell			
SARTIA, MS.	Brown sand	15	45
(mailing address)	grey sand - gravel	45	130
WELL LOCATION:			
sec. 12 T 10 N R 15 W			
6 miles West of SARTIA			
(distance) (direction) (nearest town)			
WELL PURPOSE: Irrigation			
(home, irrigation, municipal, industrial)			
WELL COMPLETION DATA:			
(1) diameter (inches) 8			
(2) total depth (feet) 130			
(3) static water level (feet) 20 below top of ground.			
(4) casing PVC 90 (material) (depth)			
8 (size) if telescope see back.			
(5) screen 40 90 (length) (depth to top)			
8 PVC (size) (material)			
(6) pump 20 1,000 (HP) (yield gpm)			
(type power)			
(7) electric log no (yes or no)			
(organization running log)			
(8) how well bottom plugged			
CAIP			

RECEIVED

JUL 8 1987


Department of Natural Resources  
Bureau of Land & Water Resources

DRILLERS REMARKS:

MS - GW  
Permit 02158

If well telescopes please sketch and show depths.

GROUND LEVEL

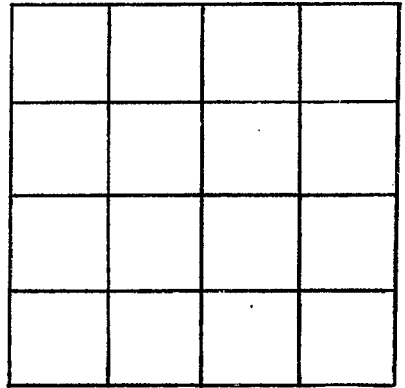

SECTION \_\_\_\_\_

Please indicate well location X.

ADDITIONAL INFORMATION

If more than one screen,  
show locations of each on sketch.