

MISSISSIPPI DEPARTMENT OF NATURAL RESOURCES

Bureau of Land and Water Resources

Southport Mall

P.O. Box 10631

Jackson, Mississippi 39209

WATER WELL DRILLERS LOG

Permit Applied For

YAZOO  
P 293720

3-17 1988  
date well completed

88 Days Well  
firm name

Yazoo County  
county well located

LANDOWNER: Thomas Strickland

Description of formations encountered

from

to

Star Rt. Box 25  
Sartoria Ms 39162  
(mailing address)

Clay	0	28
Fine Sand	28	71
Fine Sand & Gravel	71	88
Sand & Gravel	88	110
M SAND & Gravel	110	120
Sand & Gravel	120	130

WELL LOCATION:

sec 35 T 10 N R 4 E  
5 miles NW of Sartoria  
(distance) (direction) (nearest town)

WELL PURPOSE: Irrigation  
(home, irrigation, municipal, industrial)

WELL COMPLETION DATA:

- (1) diameter (inches) 16"
- (2) total depth (feet) 130'
- (3) static water level (feet) \_\_\_\_\_ below/above top of ground.
- (4) casing steel (material), \_\_\_\_\_ (depth),  
16 (size) if telescope see back.
- (5) screen 40 (length), \_\_\_\_\_ (depth to top),  
16 (size), \_\_\_\_\_ (material)
- (6) pump 60 (HP), \_\_\_\_\_ (yield gpm)  
Gear (type power)
- (7) electric log No (yes or no)  
None (organization running log)
- (8) how well bottom plugged Plate.

RECEIVED


MAY 02 1988

Department of Natural Resources  
Bureau of Land & Water Resources

DRILLERS REMARKS:

If well telescopes please  
sketch and show depths.

GROUND LEVEL

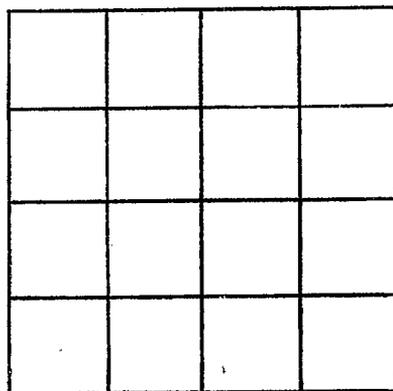

SECTION \_\_\_\_\_

Please indicate well location X.

ADDITIONAL INFORMATION

If more than one screen,  
show locations of each on sketch.