

YA200  
P45  
9-1-70

MISSISSIPPI  
BOARD OF WATER COMMISSIONERS  
416 North State Street  
Jackson, Mississippi 39201

**CODED**

**WATER WELL DRILLERS LOG**

Sept. 1 1970 <sup>L.H.</sup> Lee "Cesswell" Yazoo  
date well completed firm name county well located  
WATER WELL DRILLING

LANDOWNER:	description of formations encountered	from	to
<u>Lee Trammell</u> <u>Yazoo City Min-</u> (mailing address)	<u>gumbo</u>	<u>0</u>	<u>20</u>
	<u>hard gravel</u>	<u>20</u>	<u>152</u>
	<u>Clay</u>	<u>152</u>	<u>520</u>
	<u>shale &amp; shales and</u>	<u>520</u>	<u>840</u>
	<u>sand</u>	<u>840</u>	<u>940</u>
WELL LOCATION: sec. <u>18</u> T. <u>10</u> N. R. <u>4</u> <u>5</u> miles <u>West</u> of <u>Satartia</u> (distance) (direction) (nearest town)			
WELL PURPOSE: <u>Drinking</u> (home, irrigation, municipal, industrial)			
WELL COMPLETION DATA:			
(1) diameter (inches) <u>4 x 2</u>			
(2) total depth (feet) <u>940</u>			
(3) static water level (feet) <u>4</u> below top of ground.			
(4) casing <u>Blk. Pipe</u> <u>168</u> (material) (depth)			
<u>4</u> If telescope see back. (size)			
(5) screen <u>20</u> <u>920</u> (length) (depth to top)			
<u>2</u> <u>Steel</u> (size) (material)			
(6) pump <u>3/4</u> <u>20</u> (HP) (yield gpm)			
<u>0</u> (type power)			
(7) electric log <u>no</u> (yes or no)			
(organization running log)			
(8) how well bottom plugged <u>Steel plug</u>			
DRILLERS REMARKS:			


**CODED**

SEP 15 1970

MISS. BD. OF  
WATER COMM.

If well telescopes please sketch and show depths.

GROUND LEVEL

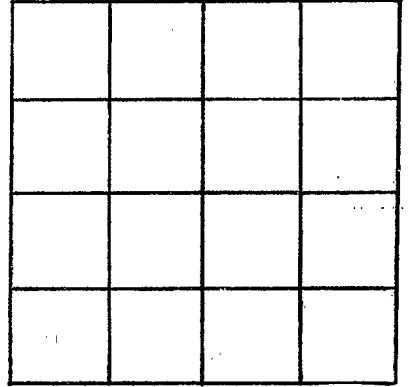

SECTION \_\_\_\_\_

Please indicate well location X.

ADDITIONAL INFORMATION

If more than one screen,  
show locations of each on sketch.