

Y0700
 P46
 7-4-70

MISSISSIPPI
 BOARD OF WATER COMMISSIONERS
 416 North State Street
 Jackson, Mississippi 39201

CODED

WATER WELL DRILLERS LOG

July 4 1970 E.M. "Bud" Cresswell Y0700
 date well completed firm name county well located

LANDOWNER:
 EDWARD ROBERTS
 SATARTIA, Miss-
 (mailing address)

description of formations encountered	from	to
quombo	0	12
granul-gravel	12	90
shale	90	380
hard shale	380	450
sand	450	580

WELL LOCATION:
 sec. 26 T. 10 R. 4
 2 miles West of SATARTIA
 (distance) (direction) (nearest town)

WELL PURPOSE: Domestic
 (home, irrigation, municipal, industrial)

- WELL COMPLETION DATA:
- (1) diameter (inches) 4 X 2
 - (2) total depth (feet) 580
 - (3) static water level (feet) 0 below above top of ground.
 - (4) casing BK. steel, 147
 (material) (depth)
 4 (size) if telescope see back.
 - (5) screen 20 560
 (length) (depth to top)
 2 stainless
 (size) (material)
 - (6) pump 3/4 20
 (HP) (yield gpm)
 0 (type power)
 - (7) electric log NO
 (yes or no)
 0
 (organization running log)
 - (8) how well bottom plugged
 steel plug


CODED

JUL 21 1970
 MISS. BO. OF
 WATER COMM.

DRILLERS REMARKS:

If well telescopes please sketch and show depths.

GROUND LEVEL

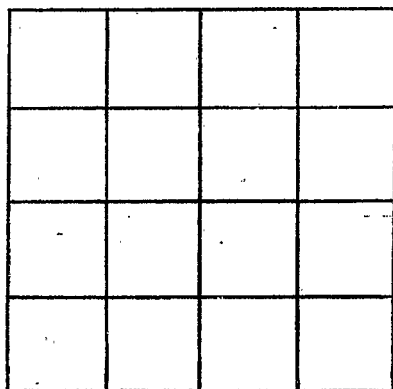

SECTION _____

Please indicate well location X.

ADDITIONAL INFORMATION

If more than one screen, show locations of each on sketch.