

Yazoo
 P 47
 4-27-70

MISSISSIPPI
 BOARD OF WATER COMMISSIONERS
 416 North State Street
 Jackson, Mississippi 39201

CODED

WATER WELL DRILLERS LOG

April 27 1970 Leaf Cresswell Yazoo
 date well completed firm name county well located

LANDOWNER:
Buddy Hatchett
Leaf Bluff, Miss.
 (mailing address)

description of formations encountered	from	to
	<u>granite</u>	<u>0</u>
<u>clay</u>	<u>15</u>	<u>45</u>
<u>sand-gravel</u>	<u>45</u>	<u>89</u>

WELL LOCATION:
 sec. 5 T. 10^N R. 5^W
8 miles South of Leaf Bluff
 (distance) (direction) (nearest town)

WELL PURPOSE: Home
 (home, irrigation, municipal, industrial)

- WELL COMPLETION DATA:
- (1) diameter (inches) 2
 - (2) total depth (feet) 89
 - (3) static water level (feet) 18 below/above top of ground.
 - (4) casing galv. 84
 (material) (depth)
2 if telescope see back.
 (size)
 - (5) screen 5 84
 (length) (depth to top)
2 Stainless
 (size) (material)
 - (6) pump _____ (HP) _____ (yield gpm)
NO pump installed
 (type power)
 - (7) electric log _____ (yes or no)
 _____ (organization running log)
 - (8) how well bottom plugged plug

CODED


MADE BY
 WAT 21 B/D

DRILLERS REMARKS:

DRILLER'S NAME
 COMPANY

If well telescopes please sketch and show depths.

GROUND LEVEL

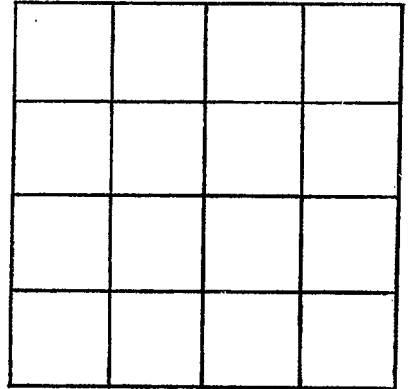

SECTION _____

Please indicate well location X.

ADDITIONAL INFORMATION

If more than one screen,
show locations of each on sketch.