

Yazoo Co  
 P48  
 4-9-70

MISSISSIPPI  
 BOARD OF WATER COMMISSIONERS  
 416 North State Street  
 Jackson, Mississippi 39201

WATER WELL DRILLERS LOG

April 9 1970 Bud Cresswell Yazoo  
 Date well completed firm name county well located

LANDOWNER:  
 Tod King  
 ROUTE  
 Yazoo City, Miss.  
 (mailing address)

description of formations encountered	from	to
	gumbo sand	0
sand-gravel	15	60
	60	89

WELL LOCATION:  
 sec. 34 T10 R5 S150  
 10 miles S.W. of Satastia  
 (distance) (direction) (nearest town)

WELL PURPOSE: Dr. Me. Site  
 (home, irrigation, municipal, industrial)

- WELL COMPLETION DATA:
- (1) diameter (inches) 2
  - (2) total depth (feet) 89
  - (3) static water level (feet) 22 below top of ground.
  - (4) casing galv. 84  
 (material) (depth)  
2 if telescope see back.  
 (size)
  - (5) screen 5 84  
 (length) (depth to top)  
2 Stainless  
 (size) (material)
  - (6) pump \_\_\_\_\_ (HP) \_\_\_\_\_ (yield gpm)  
 \_\_\_\_\_ (type power)
  - (7) electric log \_\_\_\_\_ (yes or no)  
 \_\_\_\_\_ (organization running log)
  - (8) how well bottom plugged \_\_\_\_\_


APR 24 1970

DRILLERS REMARKS:

MISS. BD. OF  
 WATER COMM.

If well telescopes please sketch and show depths.

GROUND LEVEL

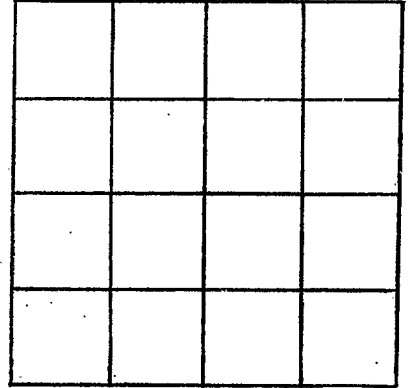

SECTION \_\_\_\_\_

Please indicate well location X.

ADDITIONAL INFORMATION

If more than one screen, show locations of each on sketch.