

MISSISSIPPI DEPARTMENT OF NATURAL RESOURCES

Bureau of Land and Water Resources

Southport Mall

P.O. Box 10631

Jackson, Mississippi 39209

WATER WELL DRILLERS LOG

CODED

P.51
YAZOO CO.
11-4-83

11-4-83
date well completed

Griner Drilling Service, Inc.
firm name

Yazoo
county well located

LANDOWNER:

Transcontinental Drilling
1700 Capitol Towers
Jackson, MS. 39201-3383
(mailing address)

description of formations encountered

from

to

clay

0 75

sand, gravel

75 130

clay

130 150

WELL LOCATION: 531 N + 239016

No. 3 sec. 31 T. 10 N. R. 4 S. S.W. 1/4
Columbus Smith miles S. of Sartoris
(distance) (direction) (nearest town)

WELL PURPOSE: oilfield supply
(home, irrigation, municipal, industrial)

WELL COMPLETION DATA:

- (1) diameter (inches) 3"
- (2) total depth (feet) 150'
- (3) static water level (feet) 15' ^{below} _{above} top of ground.
- (4) casing Steel, 131'
(material) (depth)
3"
(size) if telescope see back.
- (5) screen 42' 89'
(length) (depth to top)
3" perforated
(size) (material)
- (6) pump — 100
(HP) (yield gpm)
AC
(type power)
- (7) electric log —
(yes or no)
—
(organization running log)
- (8) how well bottom plugged orange peel

CODED

DEPT. OF NATURAL RESOURCES
BUREAU OF LAND & WATER RESOURCES


NOV 29 1983

RECEIVED

DRILLERS REMARKS:

If well telescopes please sketch and show depths.

GROUND LEVEL

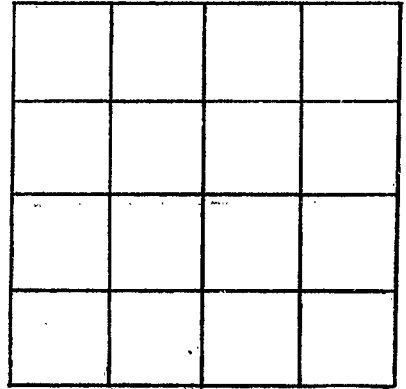

SECTION _____

Please indicate well location X.

ADDITIONAL INFORMATION

If more than one screen,
show locations of each on sketch.