

MISSISSIPPI DEPARTMENT OF NATURAL RESOURCES

Bureau of Land and Water Resources

Southport Mall

P.O. Box 10631

Jackson, Mississippi 39209

WATER WELL DRILLERS LOG

RECEIVED

MAY 23 1986

CODED

YAZOO
P 54

5-3-86

IRRIGATION EQUIPMENT

YAZOO

date well completed

Department of Natural Resources
Bureau of Land

county well located

LANDOWNER: TRAVELERS INSURANCE

description of formations encountered

from

to

Company 916 Hwy 82 West.

clay 0 10
FINE SAND 10 55
COARSE SAND / PEA GRAVEL 55 115

GREENWOOD, MS

(mailing address)

WELL LOCATION:

sec. 2 T 10 N R 5 E
S W

(distance) miles (direction) of (nearest town)

WELL PURPOSE: PIVOT
(home, irrigation, municipal, industrial)

WELL COMPLETION DATA:

- (1) diameter (inches) 16
- (2) total depth (feet) 115
- (3) static water level (feet) below top of ground.
- (4) casing steel 75' (material), (depth)
16" (size) if telescope see back.
- (5) screen 40' 75' (length), (depth to top)
16" (size), STEEL (material)
- (6) pump 200 2200 (HP), (yield gpm)
diesel (type power)
- (7) electric log (yes or no)

(organization running log)

(8) how well bottom plugged steel PLATE


DRILLERS REMARKS: Temp. Perm. +

86122 MGS 01

CODED

If well telescopes please sketch and show depths.

GROUND LEVEL

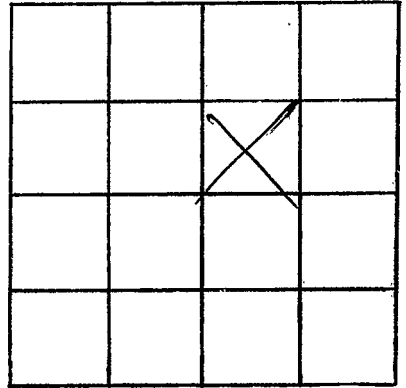

SECTION 2

Please indicate well location X.

ADDITIONAL INFORMATION

60' set of 10" column

4 stage 14" turbine

If more than one screen, show locations of each on sketch.