

County: YAZOO
Permit #: CW40429
Driller: JOHN NEWCOME O-773
Date drilling completed: 10/26/05

Mississippi Department of Environmental Quality
Office of Land and Water Resources
P.O. Box 10631
Jackson, MS 39289-0631
(601)961-5210
(601)354-6938 (fax)

Aquifer: _____
Well #: P-68
L. S. Elevation: _____
E-log #: _____

Part 2 never received
State Law requires that this report be prepared by the driller in detail and filed with the Department within 30 days of completion of drilling of the well.

Well Owner Information	Well Location
Owner Name: <u>Phillips Planting Co.</u>	Latitude: <u>32°42'18" N</u> Longitude: <u>90°36'25" W</u>
Mailing Address: <u>PO BOX 279</u>	Method of Lat/Long (circle one): Conventional Survey <u>13</u>
<u>Holly Bluff, Ms. 39088</u>	USGS quad: <u>(Hand-held GPS)</u> Survey-grade GPS <input checked="" type="checkbox"/>
City State Zip Code	<u>SW 1/4 NE 1/4</u> Sec <u>16</u> Twn <u>10N</u> Rng <u>4W</u>
Telephone No. <u>662 571-0896</u>	Distance Direction Nearest Town
	<u>4</u> Miles <u>W</u> of <u>SATARTIN</u>

Well Data

Purpose of Well (circle one) Home Industrial Public Supply Irrigation Fish Culture Other: _____

Date well drilling started: 10-26-05 Date well drilling completed: 10-26-05

If flowing, method of flow regulation: Valve _____ Other (describe) _____

Static Water Level: _____ feet above or below (circle one) land surface Date measured: _____

Method of Measurement (circle one) steel tape electric tape air line other: _____

Hole depth: 108 Well depth: 105 Well grouted to a depth of 10 feet

Type of grout (circle one): Cement Bentonite Mix

Casing length: 82 feet Casing diameter: 12" inches Type of casing: PVC

Screen length: 23 feet Screen diameter: 12" inches Type of screen: PVC

Screen slot size: .050 inches Setting depth: From 60 feet to 73 feet

Type of completion (circle all applicable): Gravel packed Underreamed Telescoped Open hole Natural Development

Other (describe): _____

Top of lap pipe or reduction in casing: _____ feet. If telescoped or more than one screen, describe on back of page

Logs run (circle all applicable): No log run Electric Gamma Ray Density Sonic Neutron Other: _____

Name of organization running log(s): _____

I certify that the well was drilled, constructed, and completed in accordance with all applicable requirements of the Mississippi Department of Environmental Quality and/or the Mississippi Department of Health regulations and state laws.

JOHN NEWCOME O-773
Print Name of Water Well Contractor and License No.


John Newcome
Signature of Water Well Contractor

FILED
BY: OLWR

If well telescopes please sketch below and show depths.

p-68


Ground Level

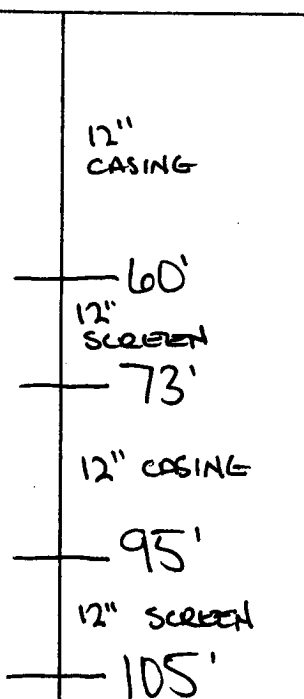

Description of Formations Encountered	From	To
TOP SOIL	0	10
MIX CLAY	10	40
FINE SAND	40	60
COARSE SAND	60	73
FINE SAND	73	95
COARSE SAND	95	105
GREY CLAY	105	108

If more than one screen, show location of each on sketch

Sketch the property layout and include the following: 1) the well location; 2) any permanent structures on the property that aid in locating the well; 3) any roads, power lines, or other items that may aid in locating the property and the well; 4) indicate direction.

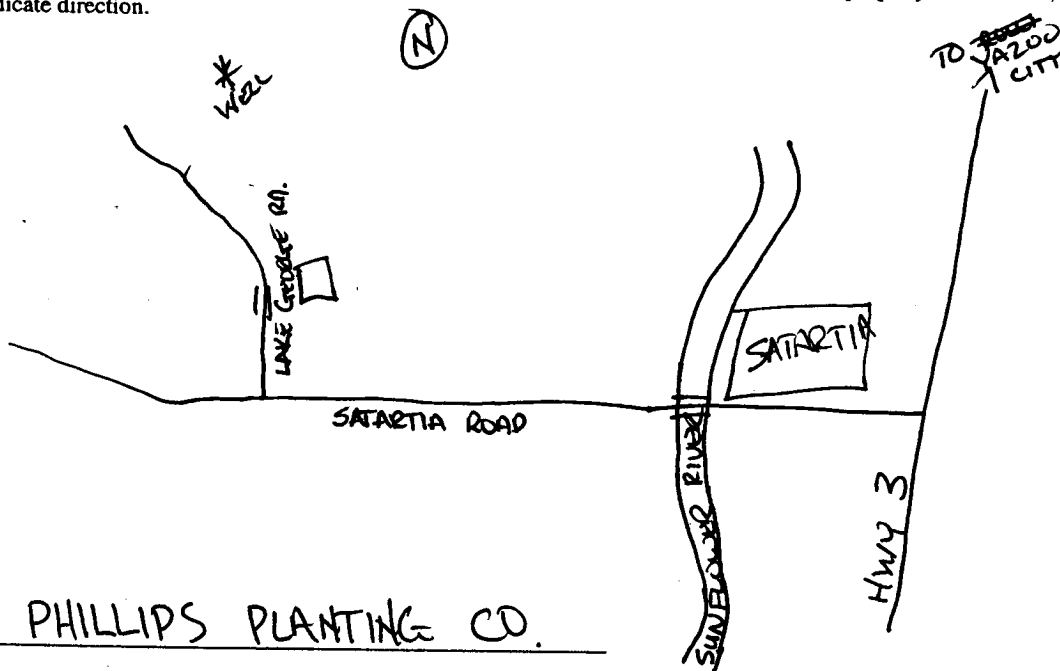

Landowner Name: PHILLIPS PLANTING CO.

 Signature of Water Well Contractor

RECEIVED
 JUN 12 1968
 BY [unclear]