<u> </u>	ell Report
County: Yazoo P	art 1 For Office Use Only:
1) (:-::-::::::::::::::::::::::::::::::::	t of Environmental Quality   Aquifer:
Permit #: Office of Land a	nd Water Resources Well #: $9-69$
s contrar.	NA 10031
Jackson, M	S 39289-0631 L. S. Elevation:
	961-5210
(601)354	I-6938 (fax) E-log #:
State Law requires that this report be prepared by the	driller in detail and filed with the Department within
30 days of completion of drilling of the well.	dinker in detail and then with the peparement within
Well Owner Information	Well Location
Philling Dlanting	32 40 49 8 90 33 12 3
Owner Name Phillips Planting	Latitude: 32, 40,49.8 Longitude: 90,33,12.3
Mailing Address: Box 279	Method of Lat/Long (circle one): Conventional Survey,
Walning Address.	
	USGS quad, Hand-held GPS, Survey-grade GPS
	NE <sub>14</sub> SE 4 Sec 25 Twn 10N Rng 4W
Holly Bluff, MS 39088	1/4 Sec Twn Rng
City State Zip Code	Distance Direction Nearest Town
662-828-3223	1 Miles NW of Satartia
Telephone No. ()	
Well I	Pivot
	Urrigation Fish Culture Other:
Date well drilling started: 5-4-06 Date w	rell drilling completed: 5-4-06
If flouring method of flour manifetion: Volve Other (d.	accriba)
If flowing, method of flow regulation: Valve Other (de	escribe)
If flowing, method of flow regulation: Valve Other (de Static Water Level: feet above or below (circle one) la	ľ
Static Water Level:feet above or below (circle one) la	and surface Date measured:
	and surface Date measured:
Static Water Level:feet above or below (circle one) la  Method of Measurement (circle one) steel tape electric tape	air line other:
Static Water Level:feet above or below (circle one) la  Method of Measurement (circle one) steel tape electric tape  Hole depth:16	air line other:
Static Water Level:feet above or below (circle one) la  Method of Measurement (circle one) steel tape electric tape	air line other:
Static Water Level:feet above or below (circle one) la  Method of Measurement (circle one) steel tape electric tape  Hole depth:16	air line other:  Well grouted to a depth of
Static Water Level:feet above or below (circle one) la  Method of Measurement (circle one) steel tape electric tape  Hole depth:16	air line other:
Static Water Level:feet above or below (circle one) la  Method of Measurement (circle one) steel tape electric tape  Hole depth:16	air line other:  Well grouted to a depth of 10 feet  inches Type of casing: PVC
Static Water Level:feet above or below (circle one) Is  Method of Measurement (circle one) steel tape electric tape  Hole depth:116	air line other:  Well grouted to a depth of 10 feet  inches Type of casing: PVC  inches Type of screen: PVC
Static Water Level:feet above or below (circle one) Is  Method of Measurement (circle one) steel tape electric tape  Hole depth:16	air line other:

Print Name of Water Well Contractor and License No.

Signature of Water Well Contractor


If well telescopes please sketch below and show depths.

Ground Level

Description of Formations Encountered	From	То
Clay	0	28
Fine Sand	29	45
Fine Sand/gravel Med. Sand/gravel	46	59
Med. Sand/gravel	60	116
		$\perp$
		1
		1
		1
		1—1
		1
		-
		+-
		-
		1
		+
		+
		<del>                                     </del>

If more than one screen, show location of each on sketch

Sketch the property layout and include the following: 1) the well location; 2) any permanent structures on the property that may aid in locating the well; 3) any roads, power lines, or other items that may aid in locating the property and the well; 4) indicate direction.

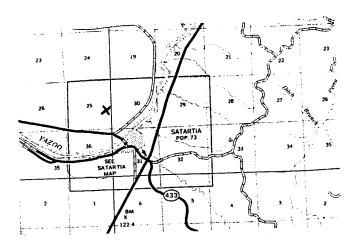

Landowner Name:		
Landowner Name.		

Signature of Water Well Contractor

## STATE WELL REPORT

## County: Yazoo Permit#:600 41118 Irrigation Equipment Date completed:

Part 2 **Pump Installer's Completion Report** Mississippi Department of Environmental Quality Office of Land and Water Resources P.O. Box 10631 Jackson, MS 39289-0631 (601)961-5210 (601)354-6938 (fax)

For Office Use Only:	
Aquifer:	
Well#: P-69	_
Elevation:	_

Copy information from block on Part 1

report must be attached and both parts f	led with the Department	contractor or a licensed pump installer. A copy of P at the above address within 30 days of well completio	
Well Owner Informa		Well Location	
Owner Name: Phillips Pla	anting	Latitude:Longitude:	
Mailing Address: Box 279		Method of Lat/Long (check one): Conventional Survey,	
		USGS quad, Hand-held GPS, Survey-gra	de GPS
Holly Bluff, MS 39088 City State Zip Code		NE 4SE 4 Sec 25 T 10N R	<u>4W</u>
		Distance Direction Nearest Town	
Telephone No. ()	•	1 Miles NW of Satartia	
Pump Type Circle one		Power Type Circle one	
Air Lift Jet	Submersible	Qiesel Engine Gasoline Engine N	atural Gas
Bucket Piston	Turbine	Electric Motor Hand Tr	actor PTO
Centrifugal Rotary	Flowing Well	Windmill Other (specify):	
Other (specify):		Horse Power Rating of Motor:	
Date Pump Installed: 6-2-06		Setting Depth: 50 feet	
1200	_Gallons Per Minute	Number of Stages: 3	
Δ++		Method of Measuring Water Level	<u> </u>
Attach Part 2 t Day that was mailed :	O Part 1	Circle one	
Str .	<sup>separate</sup>		eel Tape
Disregard letter to part 1.	24.1	Other (specify):	
part 1.	attached ;	For flowing well, measured shut in head:	feet
,	3	Well yieldedGPM with a drawd	lown of
RECEIVED	.'S	feet afterhours o	of pumping
JUN 0 6 2006			
BY: OLWR	ne best	of my knowledge.	
LI, ULWE	<u>, (</u>	Signature of Pump Installer	

RECEIVED

Form: OLWR-SWR-1B

JUN 0 6 2006

BY: OLWR