

MISSISSIPPI DEPARTMENT OF NATURAL RESOURCES
Bureau of Land and Water Resources

P.O. Box 10631
Jackson, Mississippi 39209
WATER WELL DRILLERS LOG

COUNTY WELL LOCATOR	
1A200	
WELL NUMBER	CODED
P 500	
DATE WELL COMPLETED	
7-11-90	

PERMIT NUMBER
MSGW 12910
NAME OF DRILLING FIRM
Dyn Well

NAME & MAILING ADDRESS OF LANDOWNER			
Thomas Strickland			
WELL LOCATION:	SEC	TOWNSHIP	RANGE
	36	10	N 4 E
			S 4 W
DISTANCE	DIRECTION	NEAREST TOWN	
Miles _____ of _____			
OTHER LANDMARK			
WELL PURPOSE: Home, <u>Irrigation</u> , Municipal, Industrial, Fish Pond, etc.			

PUMP DATA		
PUMP TYPE (Circle One):		
Submersible,	<u>Turbine</u>	Jet Flowing Well,
Other (Describe) _____		
POWER TYPE (Circle One):		
Electric,	Tractor,	<u>Diesel</u> , Gasoline, Butane,
Other (Describe) _____		
Pump Capacity (GPM)	No. of Stages	Setting Depth
2000	2	60 FT.
PUMP TEST		
Well yielded _____ GPM with		
a drawdown of _____ ft.		
after _____ hours of pumping		

WELL DATA		
Well Depth	Casing Diameter (In.)	Casing Length (Ft.)
111'	16"	71'
Type of Casing	Hole Depth	Depth to Static Water Level
steel		
TYPE OF COMPLETION: (Circle One or More):		
<u>Gravel Packed</u>	Underreamed,	Telescoped,
Natural Development,	Open Hole,	Other
(Describe) _____		
Top of Lap Pipe or Reduction in Casing		
FEET	IF TELESCOPED OR MORE THAN ONE SCREEN: USE BACK PAGE	

LOG DATA	
TYPE OF LOG RUN (Circle One):	
Electric, Gamma Ray, Density, Sonic, Neutron,	<u>No Log Run</u>
Other (Describe) _____	
Name of Organization Running Log	
None	

SCREEN DATA		
Diameter - Inches	Length - Feet	Slot Size - Inches
16"	40'	.030
Screen Type	Depth to Bottom - Feet	
Wire Wraps		

GEOLOGIC DATA (Office Use Only)			
Surface Elev.	Geologic Unit	Unit Thickness	Depth to Top
Subs. SWL	Date	Analysis	Aquifer Test
Driller's Remarks			


DESCRIPTION OF FORMATIONS ENCOUNTERED	FROM	TO	FORMATIONS (Continued)	FROM	TO
CLAY	0	32			
Fine Sand	32	82			
Fine Sand + Gravel	82	111			

DEC 14 1990
Department of Natural Resources
Bureau of Land & Water

IF MORE SPACE IS NEEDED, USE BACK

If well telescopes please
sketch and show depths.

GROUND LEVEL

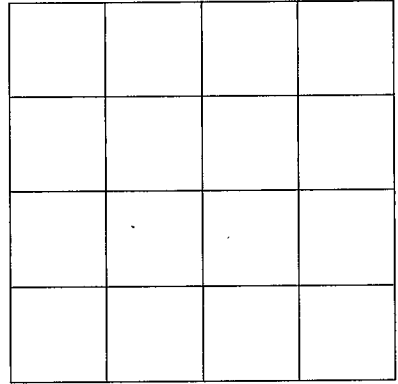

SECTION _____

Please indicate well location X.

ADDITIONAL INFORMATION

If more than one screen,
show location of each on sketch.