

Yazoo  
 PI 3001  
 May 27, 1977

MISSISSIPPI  
 BOARD OF WATER COMMISSIONERS  
 416 North State Street  
 Jackson, Mississippi 39201

WATER WELL DRILLERS LOG

May 27 1977 E.M. "Bud" Cresswell Yazoo  
 date well completed firm name county well located

LANDOWNER:  
 Bob Hicks  
 SATARTIA, MS.  
 (mailing address)

description of formations encountered	from	to
Clay	0	30
Sand - gravel	30	90
Clay	90	320
Sandy shale	320	460
Sand	460	560

WELL LOCATION:  
 sec. 25 T 10 N R. 4 E  
 1 mile N West of SATARTIA  
 (distance) (direction) (nearest town)

WELL PURPOSE: Home  
 (home, irrigation, municipal, industrial)

- WELL COMPLETION DATA:
- (1) diameter (inches) 4
  - (2) total depth (feet) 560
  - (3) static water level (feet) 0 below top of ground.
  - (4) casing Steel 540  
 (material) (depth)  
 4 (size) if telescope see back.
  - (5) screen 20 540  
 (length) (depth to top)  
 2 STAINLESS  
 (size) (material)
  - (6) pump 1 25  
 (HP) (yield gpm)  
 0 (type power)
  - (7) electric log No  
 (yes or no)  
 0 (organization running log)
  - (8) how well bottom plugged Steel plug


DRILLERS REMARKS:

RECEIVED  
 JUN 20 1977

MISS. DD. OF WATER COMMISSIONERS

If well telescopes please sketch and show depths.

GROUND LEVEL

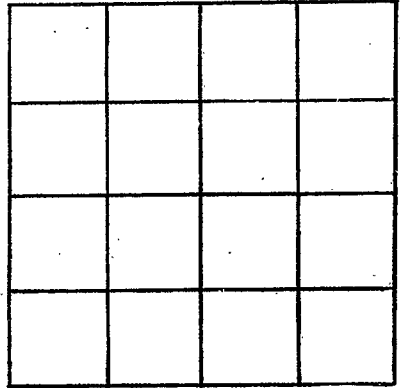

SECTION \_\_\_\_\_

Please indicate well location X.

ADDITIONAL INFORMATION

If more than one screen, show locations of each on sketch.