

Yazoo
 PO 20031
 6-3-77

MISSISSIPPI
 BOARD OF WATER COMMISSIONERS
 416 North State Street
 15J Jackson, Mississippi 39201

WATER WELL DRILLERS LOG

June 3 1977 K.M. "Bud" Cresswell Yazoo
 date well completed firm name county well located

LANDOWNER:	description of formations encountered	from	to
P.C. McInnis SARTORIA, MS. (mailing address)			

WELL LOCATION:
 sec. 36 T 10 N R 4 W
 1 miles West of SARTORIA
 (distance) (direction) (nearest town)

WELL PURPOSE: none
 (home, irrigation, municipal, industrial)

- WELL COMPLETION DATA:
- (1) diameter (inches) 2
 - (2) total depth (feet) 85
 - (3) static water level (feet) 25 below top of ground
 - (4) casing PVC 80
 (material) (depth)
 2 (size) If telescope see back.
 - (5) screen 5 80
 (length) (depth to top)
 2 PVC
 (size) (material)
 - (6) pump 1 5
 (HP) (yield gpm)
 0 (type power)
 - (7) electric log no
 (yes or no)
 0 (organization running log)
 - (8) how well bottom plugged
 Steel plug


DRILLERS REMARKS:

RECEIVED
 JUN 20 1977

MISS. BD. OF WATER COMMISSIONERS

If well telescopes please sketch and show depths.

GROUND LEVEL

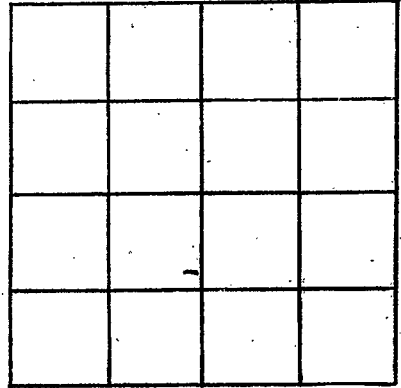

SECTION _____

Please indicate well location X.

ADDITIONAL INFORMATION

If more than one screen, show locations of each on sketch.