

YAZOO
P <i>[Signature]</i>
3-06-79

MISSISSIPPI
 BOARD OF WATER COMMISSIONERS
 416 North State Street
 Jackson, Mississippi 39201

WATER WELL DRILLERS LOG

March 6 19*79* *E.M. "Bud" Cresswell* *Yazoo*
 date well completed firm name county well located

LANDOWNER:
Barrie Bros.
Yazoo City, Ms.
 (mailing address)

description of formations encountered	from	to
	<i>Clay Sand & gravel</i>	<i>0</i>
	<i>40</i>	<i>120</i>

WELL LOCATION:
 sec. *14* T *10* N R *4* W
4 miles *West* of *SATARTIA*
 (distance) (direction) (nearest town)

WELL PURPOSE: *home*
 (home, irrigation, municipal, industrial)

- WELL COMPLETION DATA:
- (1) diameter (inches) *4*
 - (2) total depth (feet) *120*
 - (3) static water level (feet) *12* below above top of ground.
 - (4) casing *PVC* *100*
 (material) (depth)
4 If telescope see back.
 (size)
 - (5) screen *20* *100*
 (length) (depth to top)
4 *PVC*
 (size) (material)
 - (6) pump *1* *30*
 (HP) (yield gpm)
0
 (type power)
 - (7) electric log *no*
 (yes or no)
 - (organization running log)
 - (8) how well bottom plugged *Steel plug*

DRILLERS REMARKS:


Miss. Board of Water Comm.

MAR 13 1979

RECEIVED

If well telescopes please sketch and show depths.

GROUND LEVEL

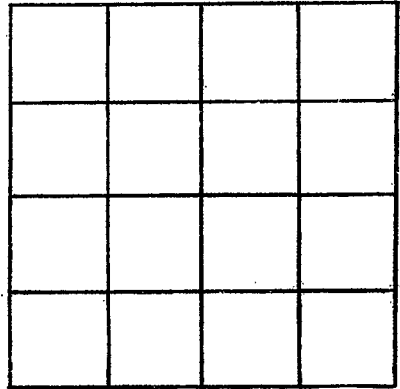

SECTION _____

Please indicate well location X.

ADDITIONAL INFORMATION

If more than one screen, show locations of each on sketch.